

CERTIFIED LAND CORNER RESTORATION


Index No. G-5

State of Wisconsin } ss.
County of Marathon

I Keith R. Vreeland, do hereby certify that on the about 4th day of June, 1973, I found evidence of the East 1/4 corner of Section 7 Township 31 N, Range 14 E, Fourth, Principal Meridian, as described hereon; and that from this evidence I established a new monument and accessories as described hereon to perpetuate the original location of this corner.

Resident witnesses:

As shown on tie sheet

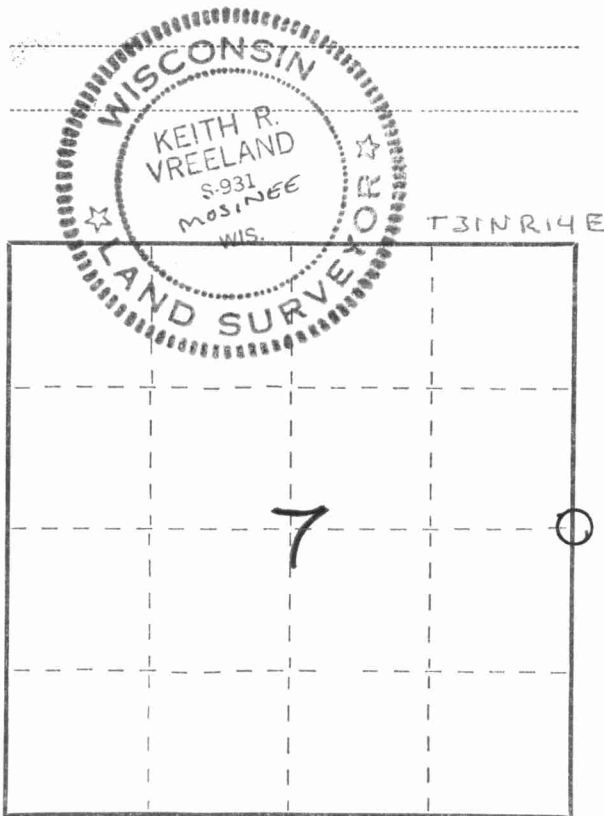


○ = Corner monument restored.

History of original corner establishment:

Reviewed original government land surveyors field books including bearing tree identification, distances and bearings to all corners in Section 7 and adjacent Sections. Checked County records for evidence of any re-surveys since the original monumentation. Right of way plat for STH 64, Division Job No. 7200, State of Wis. Division of Highways only evidence found. Plat shows ties to some corners or apparent corners. Ordered aerial photography of scale of 1" = 400' and laid out sections thereon. Ran coordinate traverses with picture points for vertical and horizontal control for aerial topographic mapping. Topographic mapping to a scale of 1" = 100' co-ordinate controlled to closed traverses with closings of not less than 1 in 10,000. Traverses balanced. Laid out sections to scale Description of corner evidence found: and evidence on 1" = 100' mapping. Started from apparent corner (SE of Sec. 7) and chained west, north, east and south around the periphery of Section 7. Reviewed existing possession lines, searched, probed and dug for evidence of original corners.

DESCRIPTION OF CORNER EVIDENCE FOUND. No evidence of original corner. Fence line along east line SE 1/4 Sec. 7 meanders. Appears to be quite straight for about 1800' to north than gradually bends somewhat to the northwest. Set corner to best match existing evidence and traverse information.

Description of monument and accessories I established to perpetuate the original location of this corner.

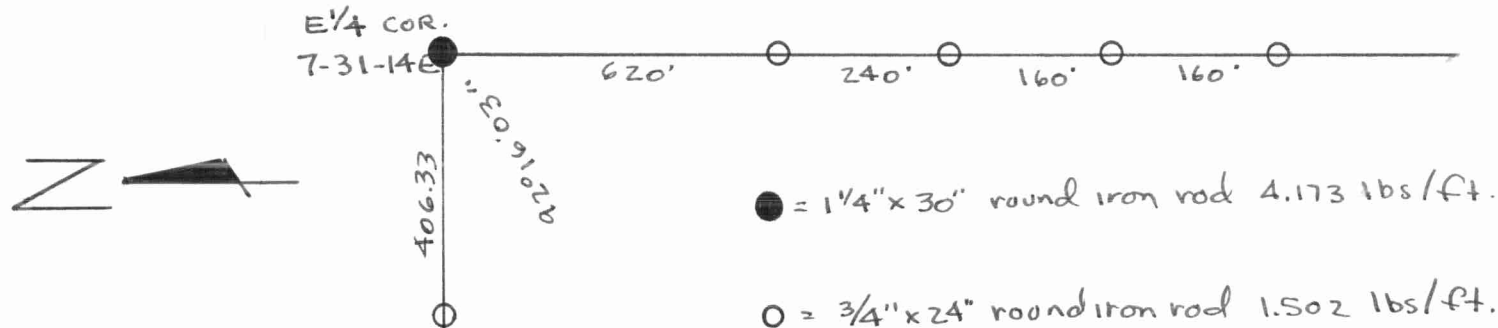

Dated at Mosinee, Wis. Wis., this 27th day of August, 1980

Signature: Keith R. Vreeland Title: Reg. Land Surveyor Registration No. S 0931
(County Surveyor, Registered Land Surveyor, or other duly authorized official)

Office of Register of Deeds, County of _____, I hereby certify that the within instrument was filed in this office for record on the _____ day of _____, 19____ at _____ o'clock _____ M.

(Register of Deeds)

By _____ Deputy

