


U.S. PUBLIC LAND SURVEY MONUMENT RECORD

Note: This form is intended and designed to fulfill all requirements of Wisconsin Administrative Code, Chapter A-E 7.08 U.S. Public Land Survey Monument Record (3) (a) (b) (c) (d) (e) (f) (g) (h) (i). An additional sheet may be added if necessary to conform with said requirements.

(a) Corner location: Township 31 North

Range 14 East/West

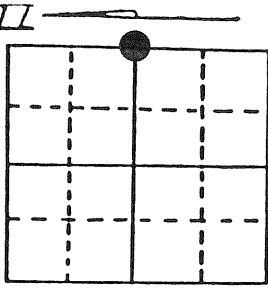

Section 7

Town/City/Village _____ Wolf River

County _____ Langlade


(b) (f) (g) (h) Description of monument found at this corner and if it was accepted, state all evidence (material, testimonial, occupational, plats, records, other monuments) used as a basis for accepting. If not accepted or if nothing was found, state evidence used as basis for establishing location. If reestablished through lost corner proportionate methods, indicate all monuments, distances and directions used to establish. Indicate type of monument found or set and sign post.

9/1857 - James McBride established this corner at 40.00 chains, set wood post and made two BTs:
 6" Birch, N67°E, 13 Links (8.58') 10" Sugar, S36°W, 24 Links (15.84')

6/1973 - Vreeland placed a 1 1/4" iron rod.

7/9/1992 - Milo E. Stefan found Vreeland's iron rod in fence line North and South.


Also, Paper Company lands has a corner N69°E, 197' - a wood post and location poster. Paper Company corner looks to be positioned from Quarter Corner 1.0 mile South and Section Corner one-half mile North. Vreeland's iron rod is placed in fence line and approximately 1 chain too far South to be proportional position. I, therefore, disregard both of the above corners and restore this corner by Lost Methods between the Section Corners North and South. We placed an aluminum monument and four new BTs.

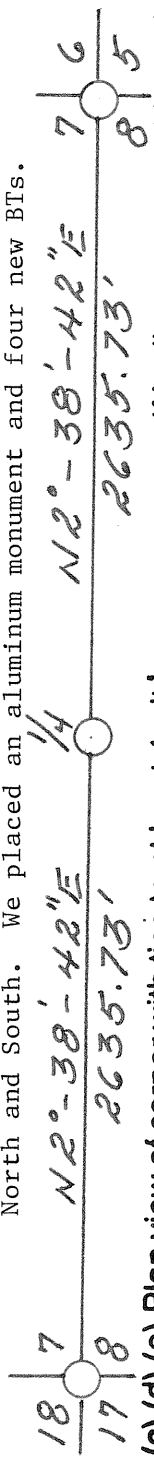

(c) (d) (e) Plan view of corner with ties to at least 4 witness monuments. If in disagreement with previously established corner, show the distances between the two corners and also indicate the ties to the disputed corner.

- 1) 2" x 42" Aluminum monument.
- 2) 4" Sugar Maple, N12°W, 24.18'.
- 3) 3" White Ash, S68°E, 13.80'.
- 4) 6" Sugar Maple, S15°W, 24.42'.
- 5) 10" Sugar Maple, N60°W, 44.81'.
- 6) Vreeland's Quarter Corner is S60°-54'-55"W, 136.83'.
- 7) Paper Company Corner is N87°-39'-03"E, 64.77'.
- 8) Plastic sign post, North, 1.2'.

Distances to nail in side of BTs.
 Stump blaze scribed "BT".

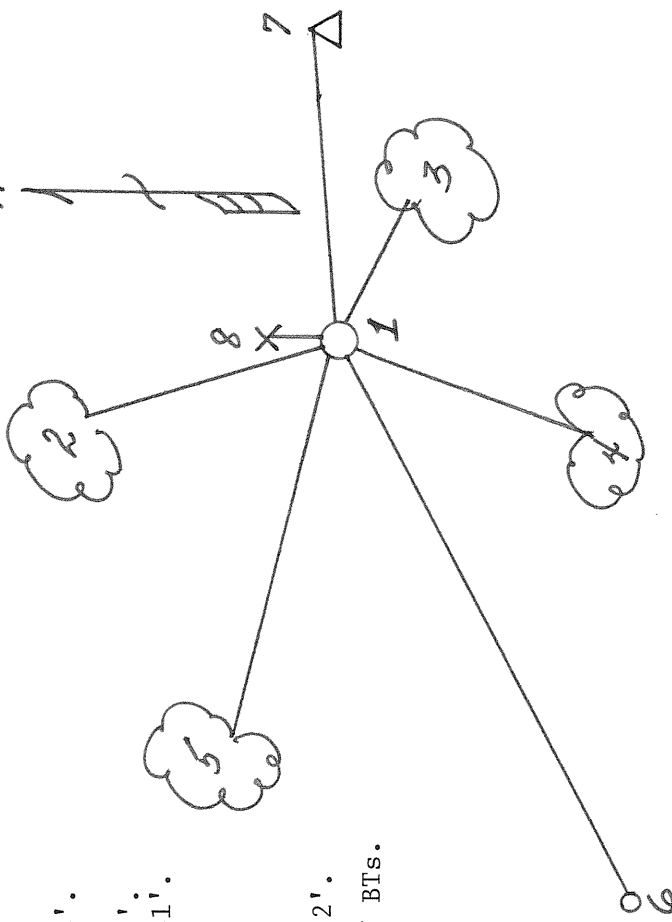

(i) I, Milo E. Stefan

(type or print name) certify that the corner location on this record was determined by me or under my direction and control and that this U.S. Public Land Survey Monument Record is correct and complete to the best of my knowledge and belief.

Signature Milo E. Stefan Date July 28, 1992



Index No. G-5

Stamp