

CERTIFIED LAND CORNER RESTORATION

31-14


Index No. J-9

State of Wisconsin }  
County of LANGLADE, } ss.

I, ROBERT J. POSS, do hereby certify that on the 26<sup>TH</sup> day of JULY, 1969, I found evidence of the SECTION corner of SECS. 8-9-16-17 Township 31, North, Range 14 EAST, Fourth, Principal Meridian, as described hereon; and that from this evidence I established a new monument and accessories as described hereon to perpetuate the original location of this corner.

Resident witnesses:

.....  
.....  
.....

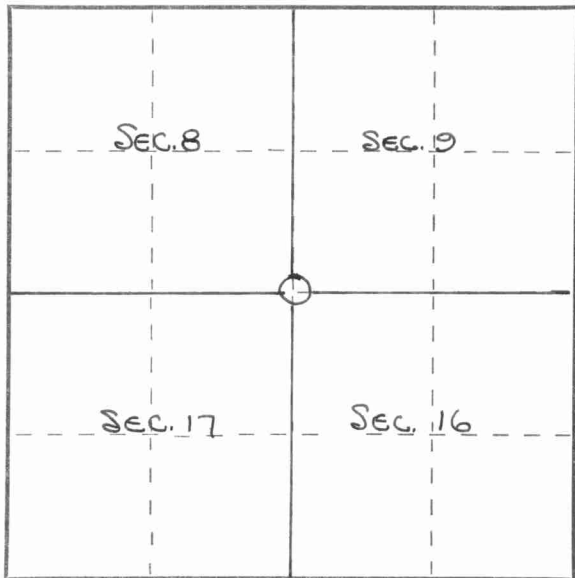


○ = Corner monument restored.

History of original corner establishment:

Description of corner evidence found:

IRON PIPE 1 1/2 RDS. EAST of CORNER. GOT INDICATION of CORNER w/ "DOODLE BUG" - BUT DID NOT DIG IT UP

Description of monument and accessories I established to perpetuate the original location of this corner.

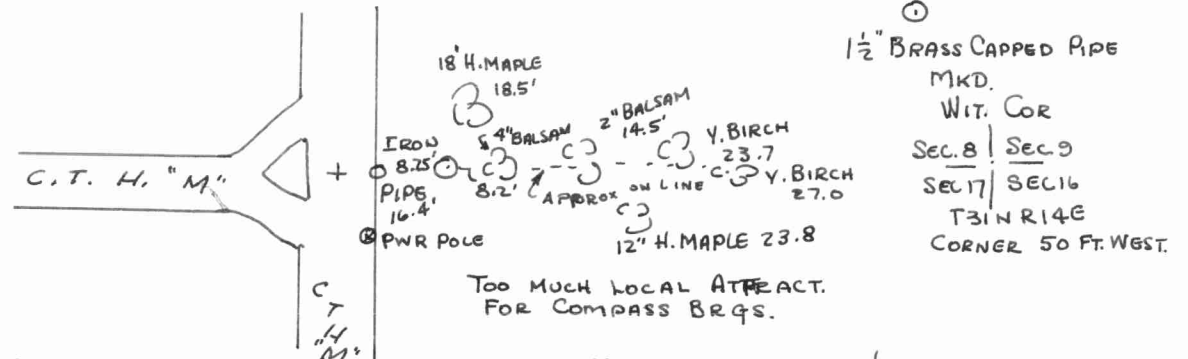

Dated at ELCHO, Wis., this 26<sup>TH</sup> day of JULY, 1969.

Signature Robert J. Poss Title REG. LAND SURVEYOR Registration No. S-0001  
(County Surveyor, Registered Land Surveyor, or other duly authorized official)

Office of Register of Deeds, County of \_\_\_\_\_, I hereby certify that the within instrument was filed in this office for record on the \_\_\_\_\_ day of \_\_\_\_\_, 19\_\_\_\_ at \_\_\_\_\_ o'clock \_\_\_\_\_ M.

(Register of Deeds)

By \_\_\_\_\_ Deputy

