


U.S. PUBLIC LAND SURVEY MONUMENT RECORD

INDEX NO. J-9

Section 8 Corner to Section 9 T31N, R14E
(Section/Quarter) 17 16

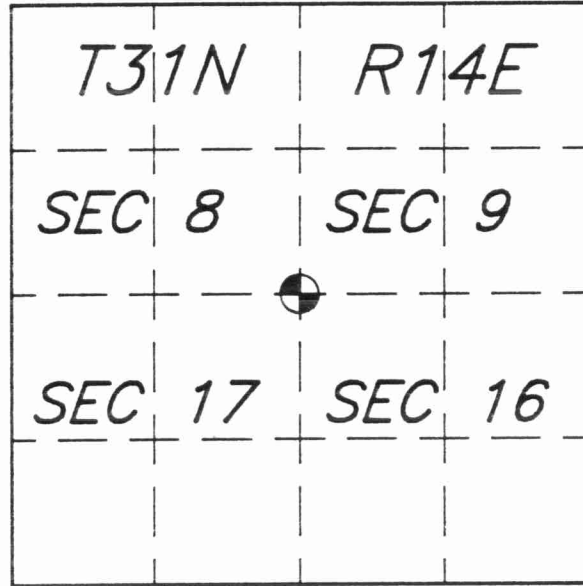

Show distances and bearings if set by proportional measurement.

○ = Corner monument restored.



I, Kim H Pritzlaff, RLS No. 1259 8/8/94
(Type or print name) certify that the corner location shown on this record was determined by me or under my direction and control and that this U.S. Public Land Survey Monument Record is correct and complete to the best of my knowledge and belief.

Kim H Pritzlaff

Signature

8/8/94

Date

History of original corner establishment, record evidence, monument evidence, occupational evidence, testimonial evidence or any other material evidence, and what you found and how the monument was set.

In 1857 James McBride, contract surveyor, set a wood post at this corner and marked bearing trees to this post.

In 1926 Robert Poss, RLS found evidence of this corner and in 1969 submitted a tie sheet showing a witness corner 50 feet east of the actual corner.

I located Poss's witness corner and 50 feet west I found a bent 2" iron pipe. I replaced the iron pipe with a 1"x 24" iron pipe with plastic cap insert and made the following new accessories to the corner.

In the plan view drawing below, provide reference ties to at least 4 witness monuments, or, if the location is within a municipality, to at least 2 witness monuments. (Witness monuments shall be made of concrete, natural stone, iron or other equally durable material, except wood other than bearing trees.) Also, show any material discrepancies between the corner restored or re-established and the location of any other previous corner location or occupation.

