

CERTIFIED LAND CORNER RESTORATION

31-14

Index No. H-13

State of Wisconsin }
County of LANGLADE } ss.

I, ROBERT J. POSS, do hereby certify that on the 22ND day of JUNE, 1968, I found evidence of the S 1/4 corner of SECS 9 & 10 Township 31, North, Range 14 EAST, Fourth, Principal Meridian, as described hereon; and that from this evidence I established a new monument and accessories as described hereon to perpetuate the original location of this corner.

Resident witnesses:

.....
.....
.....



History of original corner establishment:

Description of corner evidence found:

STONE WITH + ON TOP NEAR FENCE COR. POINTED OUT BY BUETTNER - LONG TIME OWNER OF PROPERTY. NO MARKS OF PREV. SURVEYORS

3/10/97 NOTE PLAT OF VAN OSTRAND SHOWS THIS CORNER & OTHERS IN AREA AS BEING STONES. D. T. ...

Description of monument and accessories I established to perpetuate the original location of this corner.

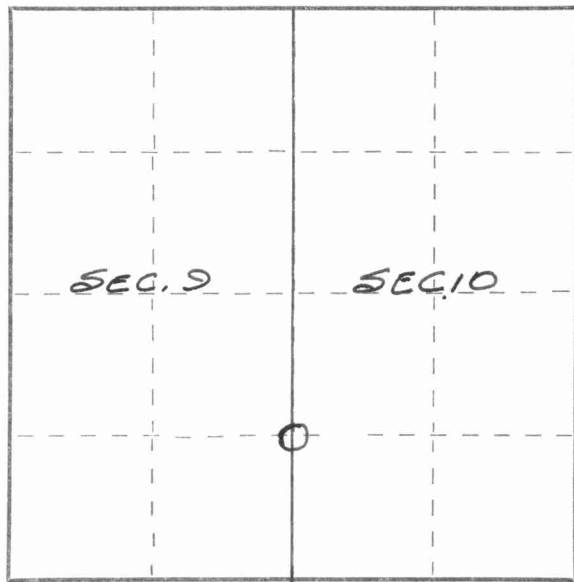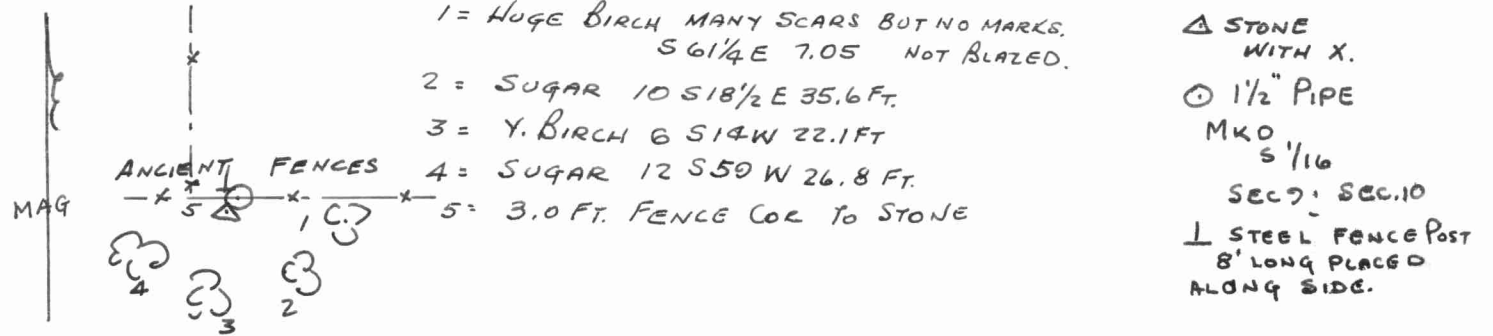

○ = Corner monument restored.

Dated at ELCHO, Wis., this 29TH day of JUNE, 1968.

Signature Robert J. Poss Title REG. LAND SURVEYOR Registration No. S-1
(County Surveyor, Registered Land Surveyor, or other duly authorized official)

Office of Register of Deeds, County of _____, I hereby certify that the within instrument was filed in this office for record on the _____ day of _____, 19____ at _____ o'clock _____ M.

(Register of Deeds)

By _____ Deputy

