


CERTIFIED LAND CORNER RESTORATION

31-14 Index No. H 11

State of Wisconsin }
County of LANGLADE } ss.

History of original corner establishment:

I, ROBERT J. POSS, do hereby certify that on the 18TH day of JULY, 1970, I found evidence of the ctr. 5/16 corner of SEC. 9 Township 31, North, Range 14 EAST, Fourth, Principal Meridian, as described hereon; and that from this evidence I established a new monument and accessories as described hereon to perpetuate the original location of this corner.

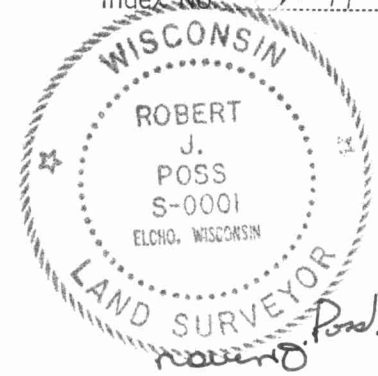

Description of corner evidence found:


FOUND SQUARED STAKE AS DESCRIBED BY AMERICAN CAN COMPANY FORESTER.

Resident witnesses:

AMERICAN CAN CO. FORESTER

Description of monument and accessories I established to perpetuate the original location of this corner.

SET 1/4" PIPE W/ GALV. CAP MKD CTR. 5/16 COR SEC 9 T 31N R 14E

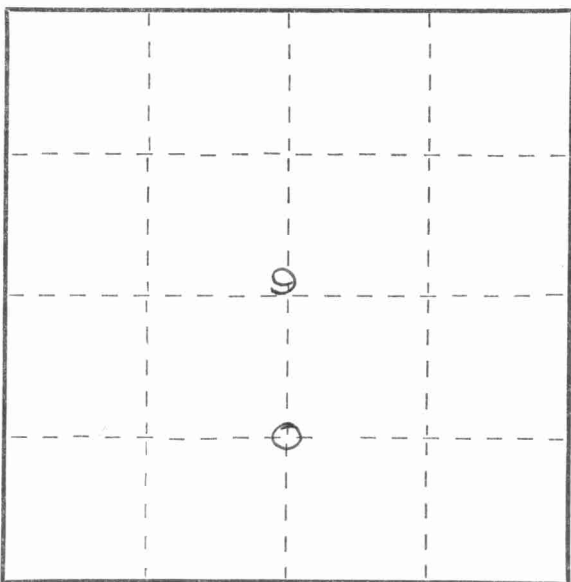

- 1= MOST EASTERLY of BASSWOOD CLUMP
- 2= HD. MAPLE W/OLD SC N 11 W 16.6
- 3= BASSWOOD TWIN AT BASE 10 S 22 1/2 W 27.4
- 4= HD. MAPLE W/BOTTOM CUT AWAY 6 S 86 E 27.3

ALL TREES BLAZED & SCRIBED NBT.

Dated at ELCHO, Wis., this 30TH day of JULY, 1970.

Signature Robert J. Poss Title REG. LAND SURVEYOR Registration No. S-0001
(County Surveyor, Registered Land Surveyor, or other duly authorized official)

Office of Register of Deeds, County of _____, I hereby certify that the within instrument was filed in this office for record on the _____ day of _____, 19____ at _____ o'clock _____ M.

(Register of Deeds)

By _____ Deputy

○ = Corner monument restored.

