

CERTIFIED LAND CORNER RESTORATION

31-14 Index No. F-13

State of Wisconsin }
County of LANGLADE } ss.

History of original corner establishment:

I ROBERT J. POSS do hereby certify that on the 20TH day of JUNE, 1970, I found evidence of the N 1/16 corner of SECS. 9 & 10 Township 31, North, Range 14E, Fourth, Principal Meridian, as described hereon; and that from this evidence I established a new monument and accessories as described hereon to perpetuate the original location of this corner.

Description of corner evidence found:

FOUND 3/4" SHAFT AT FENCE COR.
1" GALV. PIPE - 1.0 FT. WEST
SHAFT IS OLDER




Resident witnesses:


ALFRED BUETNER

Description of monument and accessories I established to perpetuate the original location of this corner.

SET 1/4" Pipe-IRON W/GALV. CAP. MKD 1/16 COR
SEC. 9 10
T31N R14E

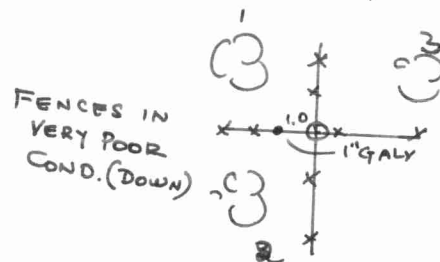

- 1 = HD. MAPLE 12 N 31 W 23.0
- 2 = WEST of TWIN BASS. 16 S 73 W 24.0
- 3 = HD. MAPLE 16 N 39 E 29.5

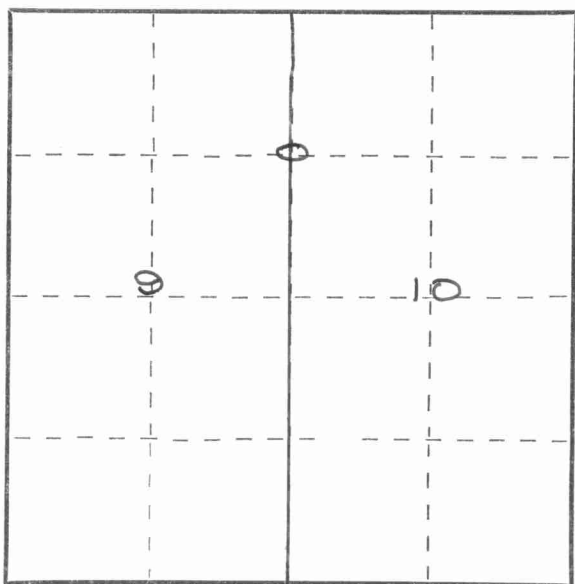

○ = Corner monument restored.

Dated at ELCITO, Wis., this 20TH day of JUNE, 1970.

Signature Robert J. Poss Title REG. LAND SURVEYOR Registration No. S-0001
(County Surveyor, Registered Land Surveyor, or other duly authorized official)

Office of Register of Deeds, County of _____, I hereby certify that the within instrument was filed in this office for record on the _____ day of _____, 19____ at _____ o'clock _____ M.

(Register of Deeds)

By _____ Deputy

