


U.S. PUBLIC LAND SURVEY MONUMENT RECORD

Note: This form is intended and designed to fulfill all requirements of Wisconsin Administrative Code, Chapter A-E 5.02, U.S. Public Land Survey Monument Record (3) (a) (b) (c) (d) (e) (f) (g) (h) (i). An additional sheet may be added if necessary to conform with said requirements.

(a) Corner location: Township 31 North

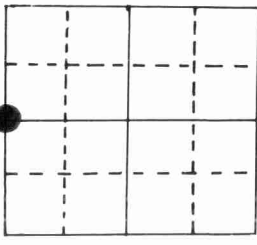

Section 15

Range 14 East ~~West~~

Town/~~City/Village~~ Wolf River

County Langlade

2" iron pipe w/cap

(b) (f) (g) (h) Description of monument found at this corner and if it was accepted, state all evidence (material, testimonial, occupational, plats, records, other monuments) used as a basis for accepting. If not accepted or if nothing was found, state evidence used as basis for establishing location. If reestablished through lost corner proportionate methods, indicate all monuments, distances and directions used to establish.


Original by J. McBride, 1857, OBT's birch 10" N39°E, 6 lks., birch 14" S22°W 21 lks.
(40.40 ch/40.40 ch)

T. Arnott, shows this corner on a Troutland Estates Plat, dated Jan. 9, 1974.

Seymour, 1986, found capped pipe and BT's twin BW 18" S 29°E 24.91'
twin BW 12" N 16°W 20.97'

Made new BT abd ref.

(c) (d) (e) Plan view of corner with ties to at least 4 witness monuments. If in disagreement with previously established corner, show the distances between the two corners and also indicate the ties to the disputed corner.

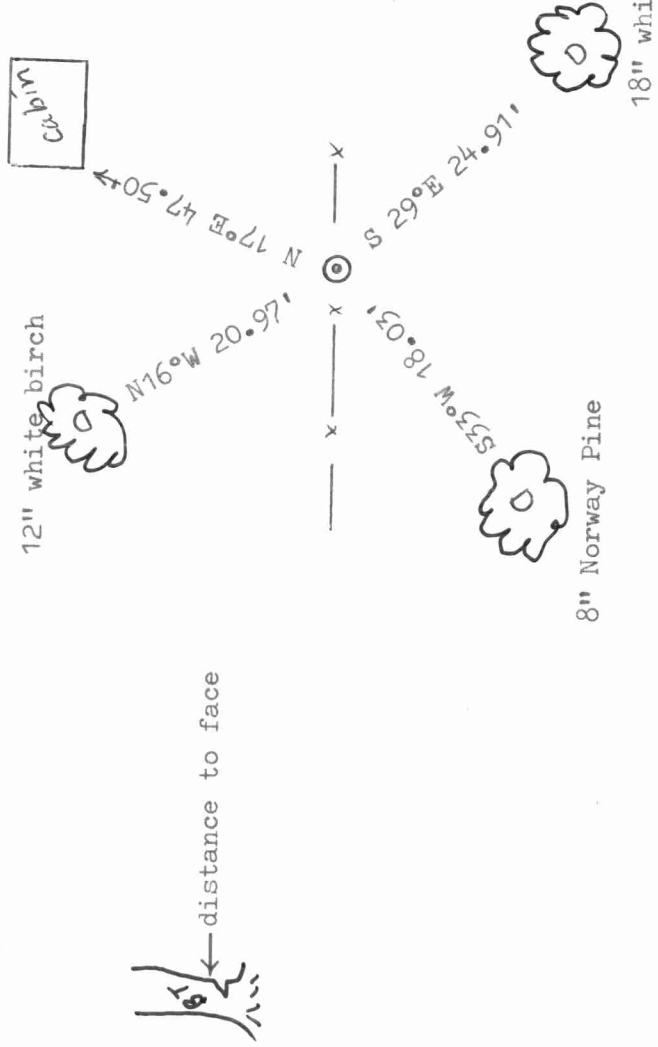

(i) I, Marvin E. Seymour

(type or print name) certify that the corner location on this record was determined by me or under my direction and control and that this U.S. Public Land Survey Monument Record is correct and complete to the best of my knowledge and belief.

Marvin E. Seymour 2/28/86

Signature

Date



J-15

