

CERTIFIED LAND CORNER RESTORATION

208483

State of Wisconsin }  
County of Langlade } ss.

I, Jean F. Resvick, do hereby certify that on the 4th day of June, 1965, I found evidence of the northwest corner of Section 18 Township 31 North, Range 15 East, Fourth Principal Meridian, as described hereon; and that from this evidence I established a new monument and accessories as described hereon to perpetuate the original location of this corner.

Description of original monument and accessories and subsequent restorations:

Surveyed in 1857 by Artemas Curtis  
80.0 chains north between Sec. 13 & 18 set wood post.  
Lynn 12", S70°W, 28 lks.  
Hemlock 12", N50°W, 60 lks.  
Hemlock 12", N70°E, 18 lks.  
Sugar 14", S42°E, 24 lks.  
3 chains north enter swamp  
9 chains east enter swamp

Description of corner evidence found:

4x4 cedar post with Forest Service poster at fence corner.  
Fence runs south and west.  
From point of cedar post, hemlock stump bears N50°W., 39.6 ft.,  
3 chains north enter swamp.  
9 chains east enter swamp.  
Fence and cedar post have been in place 35 years or longer.

Description of monument and accessories I established to perpetuate the original location of this corner:  
Replaced point of cedar post with a 2 in. inside diam., galvanized iron pipe, 5 feet long, filled with concrete, flanged at bottom, 18 ins. above ground with brass cap marked:



from which the following new bearing trees bear:  
Balsam 10 ins. diam., bears N25°W., 28.38 ft. or 43.00 lks.  
Popple 7 ins. diam. bears N64°E., 14.28 ft. or 21.63 lks.  
Popple 7 ins. diam. bears S36°E., 23.35 ft. or 35.37 lks.




REGISTERS OFFICE

LANGLADE COUNTY, WIS.

Received for record this 13th day of June, A. D. 1964, at 9:36 o'clock, and Recorded in Vol. 1 of Gen. Surv. Records on Page 15.

Recording Fee Paid \$1.50

Resident witnesses: Albert Kubish, Registrar of Deeds

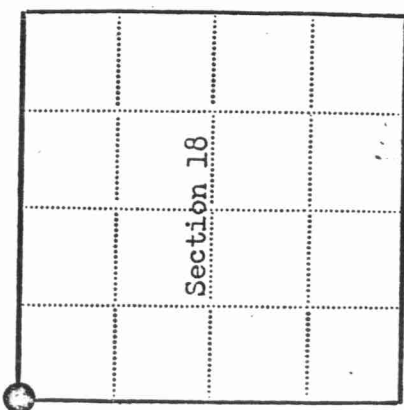

Resident witnesses.....

Dated at Rhinelander, Wisconsin, this 2th day of Aug 1965.

Signature Jean F. Resvick, Title Cadastral Surveyor (County Surveyor, Registered Land Surveyor, or other duly authorized official)

Surveyors Registration No. S-802

Office of..... County of.....

I hereby certify that the within instrument was filed in this office for record on the 19th day of June, 1965, and was filed in Book No. J-1 Page No. 104 of County Records.

Signature..... Title.....