

CERTIFIED LAND CORNER RESTORATION

Index No. G-1

31-15

State of Wisconsin }
County of LANGLADE } ss.


I WILLIAM F. KELLY, do hereby certify that on the 11th day of MARCH, 1983, I found evidence of the E. 1/4 corner of SECTION 12 Township 31, North, Range 14 EAST, Fourth Principal Meridian, as described hereon; and that from this evidence I established a new monument and accessories as described hereon to perpetuate the original location of this corner.

Resident witnesses:

.....
.....
.....


History of original corner establishment:
ORIGINAL CORNER ESTABLISHED BY
ARTEMUS CURTIS, DEPUTY SURVEYOR, 1857

Description of corner evidence found:
SET 2" x 36" ALUM. MONUMENT
ON LINE AND AT MIDPOINT
BETWEEN NE & SE CORNERS
OF SECT. 12. WORK DONE
By JOHN FISHER IN
OCT 1982

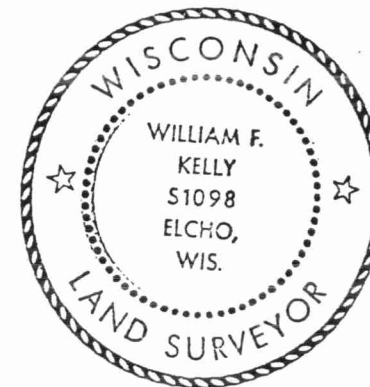

William F. Kelly

Description of monument and accessories I established to perpetuate the original location of this corner.

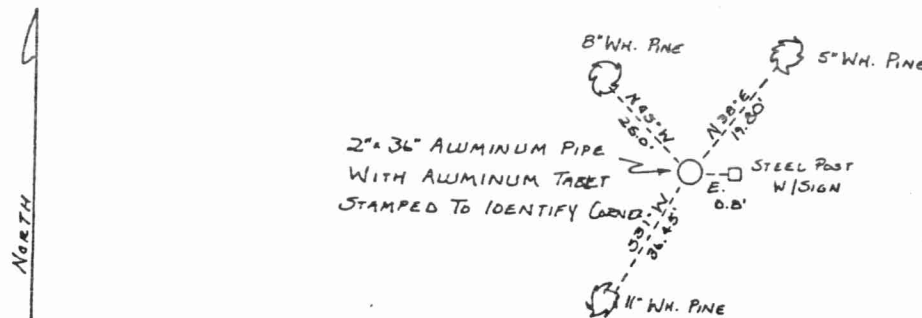


Dated at ELCHO, Wis., this 11th day of MARCH, 1983.

Signature William F. Kelly Title COUNTY SURVEYOR Registration No. 1098
(County Surveyor, Registered Land Surveyor, or other duly authorized official)

Office of Register of Deeds, County of _____, I hereby certify that the within instrument was filed in this office for record on the _____ day of _____, 19____ at _____ o'clock _____ M.

.....
(Register of Deeds)

By _____ Deputy

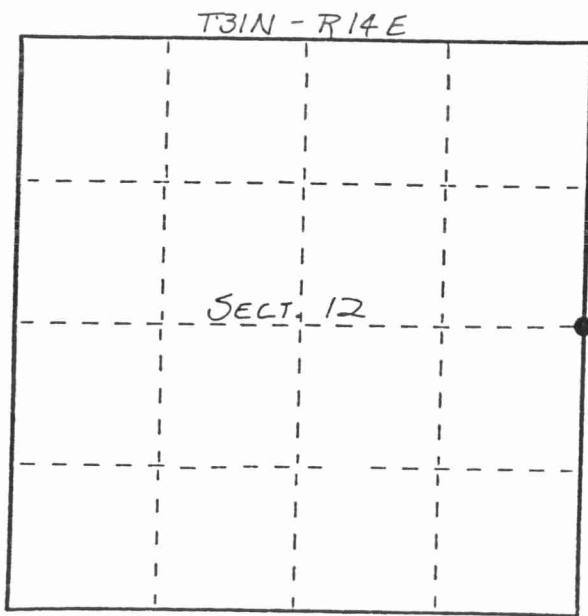

○ = Corner monument restored.