

CERTIFIED LAND CORNER RESTORATION


Index No. N-23

State of Wisconsin }
 County of LANGLADE } ss.

I, WESLEY J. TRADEWELL, do hereby certify that on the 23RD day of MAY, 19 79, I found evidence of the SOUTH 1/4 corner of SECTION 13 Township 31, North, Range 14 EAST, Fourth Principal Meridian, as described hereon; and that from this evidence I established a new monument and accessories as described hereon to perpetuate the original location of this corner.

Resident witnesses:

.....

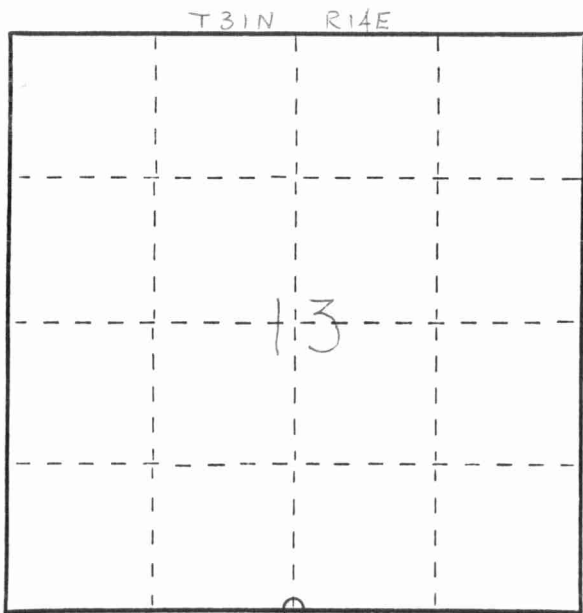

○ = Corner monument restored.


History of original corner establishment:



Description of corner evidence found:

CORNER LOST. SET 2 1/2" x 42" BLACK IRON PIPE WITH BRASS CAP BY SINGLE PROPORTION BETWEEN SE CORNER AND SW CORNER OF SECTION 13.

Description of monument and accessories I established to perpetuate the original location of this corner.

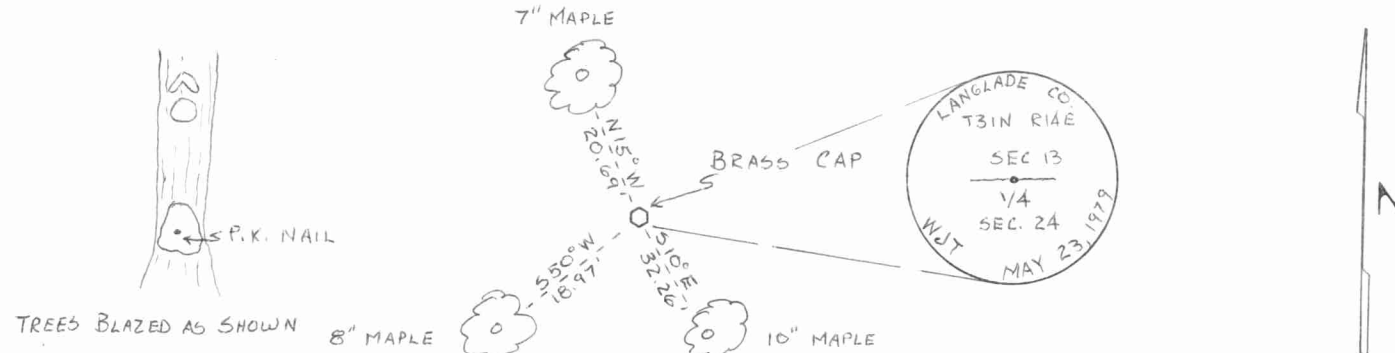

Dated at ANTIGO, Wis., this 24TH day of MAY, 19 79.

Signature Wesley J. Tradewell Title REGISTERED LAND SURVEYOR Registration No. 1342
 (County Surveyor, Registered Land Surveyor, or other duly authorized official)

Office of Register of Deeds, County of....., I hereby certify that the within instrument was filed in this office for record on the..... day of....., 19..... at..... o'clock..... M.

.....
 (Register of Deeds)

By..... Deputy

MEMORANDUM
1952