


U.S. PUBLIC LAND SURVEY MONUMENT RECORD

Note: This form is intended and designed to fulfill all requirements of Wisconsin Administrative Code, Chapter A-E 5.02, U.S. Public Land Survey Monument Record (3) (a) (b) (c) (d) (e) (f) (g) (h) (i). An additional sheet may be added if necessary to conform with said requirements.

(a) Corner location: Township 31 North

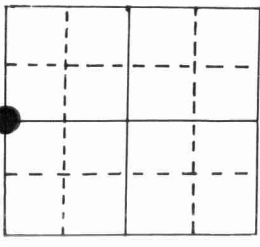

Section 22

Range 14 East

Town/~~City/Village~~ Wolf River

County Langlade


Temporary Nail

(b) (f) (g) (h) Description of monument found at this corner and if it was accepted, state all evidence (material, testimonial, occupational, plats, records, other monuments) used as a basis for accepting. If not accepted or if nothing was found, state evidence used as basis for establishing location. If reestablished through lost corner proportionate methods, indicate all monuments, distances and directions used to establish.

Original by J. McBride, 1857, OBT's heml 12" S 6°W 17 lks., heml 10" N 16°E 6 lks.
(40.15 ch / 40.15 ch)

Seymour, 1986, set ¼ corner using the corners NW 22, W¼ 22 and Ctr of NW¼ as found. The distance and direction from the west line sec. 22 to Ctr. of NW¼ was doubled over to a point to determine the N/S ¼ line. Then from that point the distance to the C¼ was computed and the same distance used to project north to set the N¼. This location fell very close to a four-way fence inter. Using a proportioned on line computation the ¼ location fell considerably north and did not fit anything good at all. See section subdivision map for data.

(c) (d) (e) Plan view of corner with ties to at least 4 witness monuments. If in disagreement with previously established corner, show the distances between the two corners and also indicate the ties to the disputed corner.

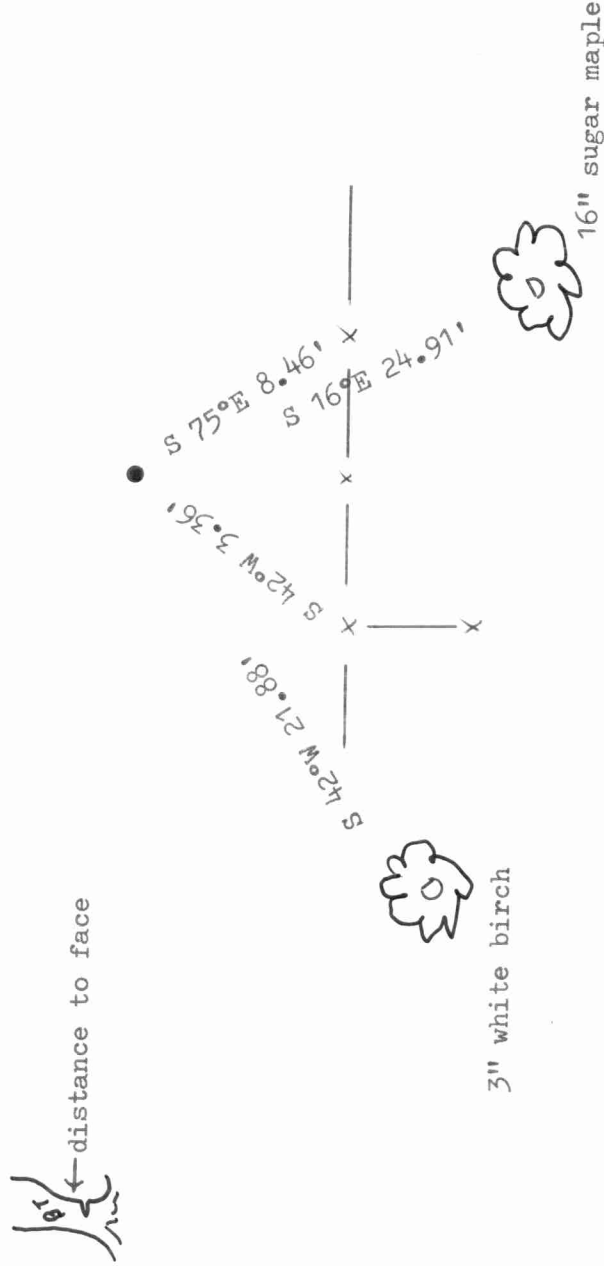

(i) I, Marvin E. Seymour
(type or print name) certify that the corner location on this record was determined by me or under my direction and control and that this U.S. Public Land Survey Monument Record is correct and complete to the best of my knowledge and belief.

Marvin E. Seymour 2/28/86
Signature Date

