


U.S. PUBLIC LAND SURVEY MONUMENT RECORD

Note: This form is intended and designed to fulfill all requirements of Wisconsin Administrative Code, Chapter A-E 5.02, U.S. Public Land Survey Monument Record (3) (a) (b) (c) (d) (e) (f) (g) (h) (i). An additional sheet may be added if necessary to conform with said requirements.

(a) Corner location: Township 31 North

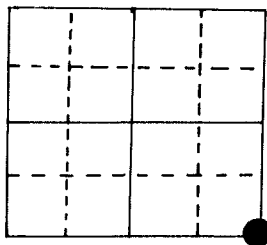

Section 15

Range 14 East ~~14~~

Town/City ~~Waukegan~~ Wolf River

County Langlade

3/4" iron pin, (now under newer blacktop)

(b) (f) (g) (h) Description of monument found at this corner and if it was accepted, state all evidence (material, testimonial, occupational, plats, records, other monuments) used as a basis for accepting. If not accepted or if nothing was found, state evidence used as basis for establishing location. If reestablished through lost corner proportionate methods, indicate all monuments, distances and directions used to establish.


Original by J. McBride, 1857, OBT's sugar 12" N28°W 20 lks., sugar 10" N46°E 16 lks., sugar 8" S23°E 44 lks., BW 10" S17°W 53 lks.

Robert Poss, 6/29/68, found 3/4" iron pin in blacktop.

Witness cor. (brass cap in conc.) set south 25.0' from sec. cor. His P. Pole references are moved to different location.

Seymour, 1986, found iron pin under new blktp.

(c) (d) (e) Plan view of corner with ties to at least 4 witness monuments. If in disagreement with previously established corner, show the distances between the two corners and also indicate the ties to the disputed corner.

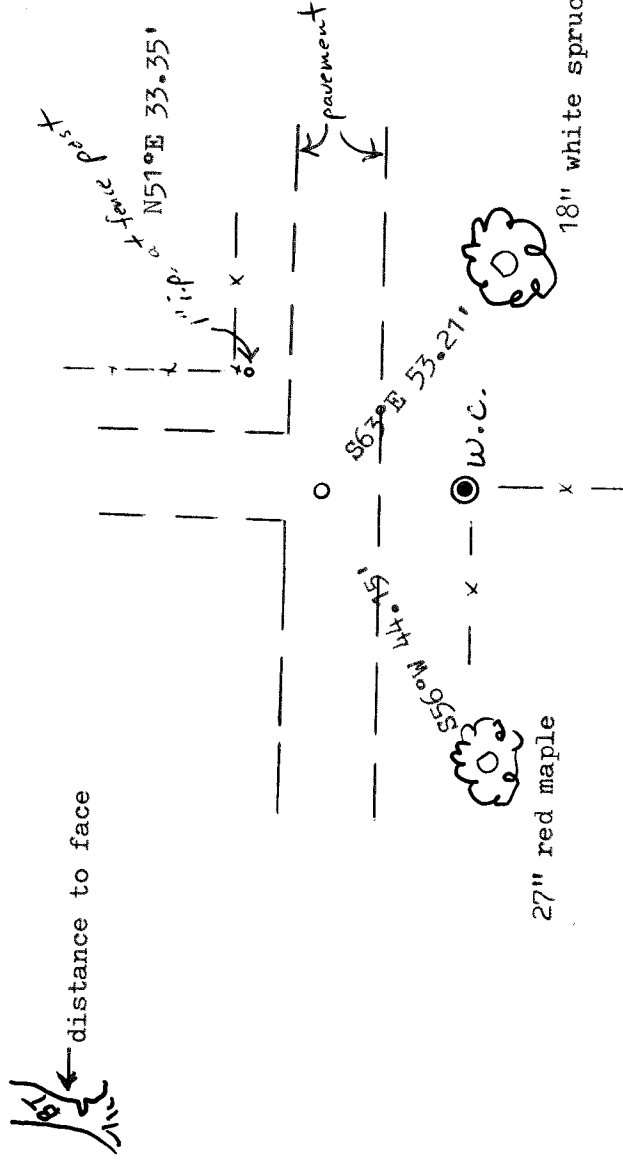

(i) I, Marvin E. Seymour

(type or print name) certify that the corner location on this record was determined by me or under my direction and control and that this U.S. Public Land Survey Monument Record is correct and complete to the best of my knowledge and belief.

Signature Marvin E. Seymour Date June 19, 1986

William D. Pelly Co. Surveyor Verified Cor. 6-25-86

