


U.S. PUBLIC LAND SURVEY MONUMENT RECORD

Note: This form is intended and designed to fulfill all requirements of Wisconsin Administrative Code, Chapter A-E 5.02, U.S. Public Land Survey Monument Record (3) (a) (b) (c) (d) (e) (f) (g) (h) (i). An additional sheet may be added if necessary to conform with said requirements.

(a) Corner location: Township 31 North

Range 14 East ~~14~~

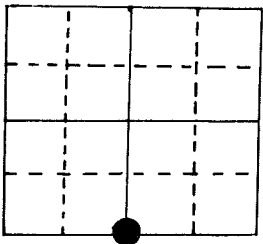

Town/~~City/Village~~ Wolf River

County Langlade

Nail w/washer

Section 15

(b) (f) (g) (h) Description of monument found at this corner and if it was accepted, state all evidence (material, testimonial, occupational, plats, records, other monuments) used as a basis for accepting. If not accepted or if nothing was found, state evidence used as basis for establishing location. If reestablished through lost corner proportionate methods, indicate all monuments, distances and directions used to establish.


Original by J. McBride, 1857, OBT's birch 10" S59°W 37 lks.
Elm 8" S 33°E 11 lks.

NOTE

T. Arnott did some erroneous type work in this area in the 50's. IN that work it was later determined that the sec. cor. south of here was off by 8 or 10'. The erroneous iron rod (prob. set by Arnott) found here is off by the same amount.

Seymour, 1986, set 1/4 cor. by proportionment methods on line between section corners.

(c) (d) (e) Plan view of corner with ties to at least 4 witness monuments. If in disagreement with previously established corner, show the distances between the two corners and also indicate the ties to the disputed corner.

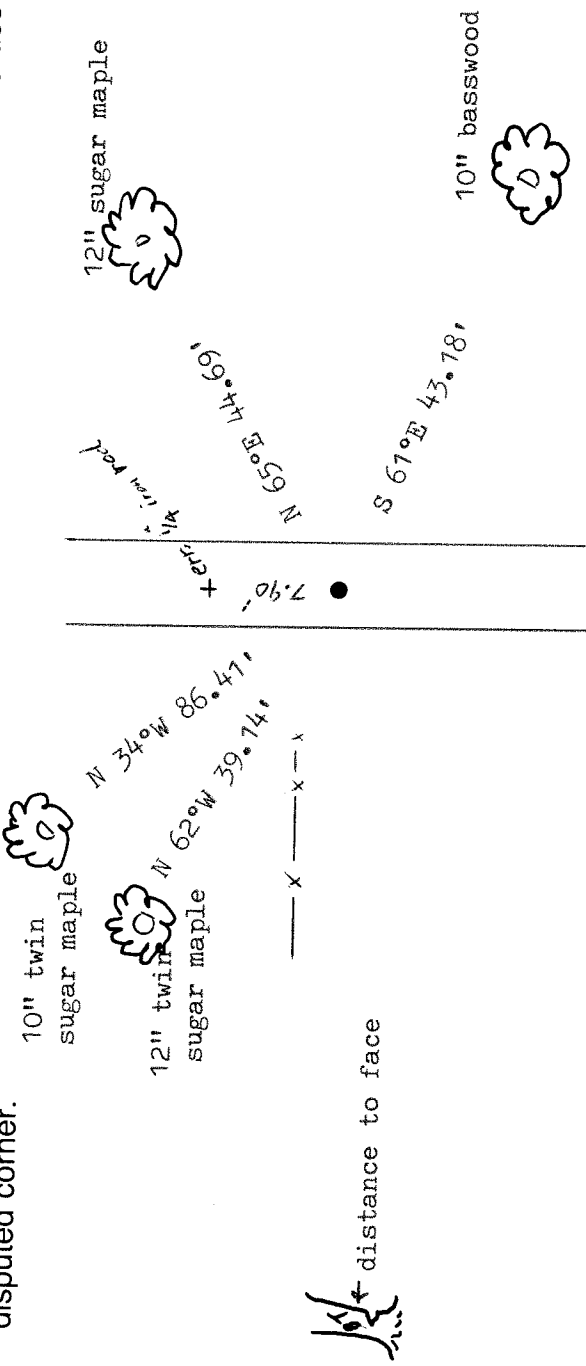

(f) I, Marvin E. Seymour

(type or print name) certify that the corner location on this record was determined by me or under my direction and control and that this U.S. Public Land Survey Monument Record is correct and complete to the best of my knowledge and belief.

Marvin E. Seymour 2/28/86
Signature Date

