


U.S. PUBLIC LAND SURVEY MONUMENT RECORD

Note: This form is intended and designed to fulfill all requirements of Wisconsin Administrative Code, Chapter A-E 7.08 U.S. Public Land Survey Monument Record (3) (a) (b) (c) (d) (e) (f) (g) (h) (i). An additional sheet may be added if necessary to conform with said requirements.

(a) Corner location: Township 31 North

Range 14 East West

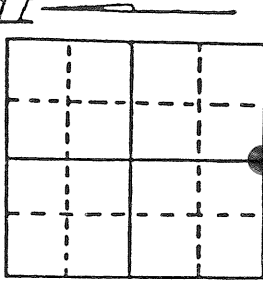

Section 18

Town/City/Village Wolf River

County Langlade

(b) (f) (g) (h) Description of monument found at this corner and if it was accepted, state all evidence (material, testimonial, occupational, plats, records, other monuments) used as a basis for accepting. If not accepted or if nothing was found, state evidence used as basis for establishing location. If reestablished through lost corner proportionate methods, indicate all monuments, distances and directions used to establish. Indicate type of monument found or set and sign post.

9/1857 - James McBride established this corner at 42.35 chains, set a wood post and made two BTs:
 14" Hemlock, S10°E, 22 Links (14.52') 12" Birch, N26°W, 26 Links (17.16')


11/16/1913 - Brooks ran North - South Quarter Line to Section 18 and found both original BTs down. He made two new BTs:
 30" Pine Stump, N4½°W, 100 Links (66.0')
 30" Pine Stump, N48°W, 84 3/4 Links (55.94')

1973 - Vreeland placed 2" iron pipe for Quarter Corner.

7/1/1992 - Milo E. Stefan found two iron pipes at this corner. Vreeland's 2" iron pipe does not fit Pine Stumps and is N47°E, 5.30' from fence corner and the other iron pipe (1½" x 24").
 Both Pine Stumps are present and fit the 1½" x 24" iron pipe. We replaced the 1½" x 24" iron pipe with an aluminum monument and made four new BTs.

(c) (d) (e) Plan view of corner with ties to at least 4 witness monuments. If in disagreement with previously established corner, show the distances between the two corners and also indicate the ties to the disputed corner.

- 1) 2" x 42" Aluminum monument.
 - 2) 10" Red Maple, N41°E, 21.77'.
 - 3) 6" White Pine, S11°E, 37.05'.
 - 4) 6" Red Maple, N68°W, 28.23'.
 - 5) 4" Hemlock, N2°W, 44.00'.
 - 6) 2" iron pipe by Vreeland, N47°E, 5.30'.
 - 7) Plastic sign post, South, .7'.
- Distances to nail in side of BTs.
 Stump blazes scribed "BT".

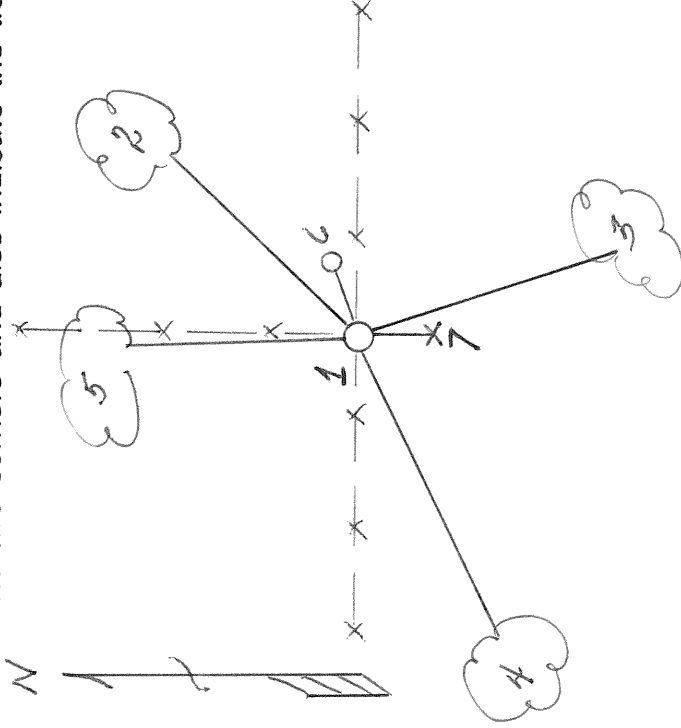

(i) I, Milo E. Stefan

(type or print name) certify that the corner location on this record was determined by me or under my direction and control and that this U.S. Public Land Survey Monument Record is correct and complete to the best of my knowledge and belief.

Milo E. Stefan

Signature

July 15, 1992

Date



Index No. N-3

Stamp