


U.S. PUBLIC LAND SURVEY MONUMENT RECORD

Note: This form is intended and designed to fulfill all requirements of Wisconsin Administrative Code, Chapter A-E 7.08 U.S. Public Land Survey Monument Record (3) (a) (b) (c) (d) (e) (f) (g) (h) (i). An additional sheet may be added if necessary to conform with said requirements.

(a) Corner location: Township 31 North

Range 14 East/West

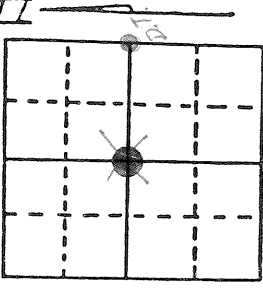

Section 18

Town/City/Village Wolf River

County Langlade

(b) (f) (g) (h) Description of monument found at this corner and if it was accepted, state all evidence (material, testimonial, occupational, plats, records, other monuments) used as a basis for accepting. If not accepted or if nothing was found, state evidence used as basis for establishing location. If reestablished through lost corner proportionate methods, indicate all monuments, distances and directions used to establish. Indicate type of monument found or set and sign post.

9/1857 - James McBride established this corner at 40.00 chains and set wood post with two BTs:

6" Hemlock, S84°W, 13 Links (8.58'). 5" Sugar, N30°E, 8 Links (5.28').

11/16/1913 - Brooks ran East - West Quarter Line to Section 18 and found stumps of both original BTs and made one new BT: 18" Hemlock, S71°E (no distance given). Brooks called distance to Center Quarter at 38.735 chains (2556.51'). OUR DISTANCE: 2552.61'.

7/6/1992 - Milo E. Stefan found 1 1/2" x 16" iron pipe with remains of Brook's BT at S71°E.

Distance to shore of lake fits well, 57' versus GLO 68'. We placed an aluminum monument and made four new BTs.


(c) (d) (e) Plan view of corner with ties to at least 4 witness monuments. If in disagreement with previously established corner, show the distances between the two corners and also indicate the ties to the disputed corner.

- 1) 2" x 42" Aluminum monument.
- 2) 6" Red Maple, N70°E, 36.58'.
- 3) 8" Hemlock, S57°E, 15.29'.
- 4) 12" Hemlock, S20°E, 13.67'.
- 5) 12" Hemlock, S78°W, 39.92'.
- 6) Plastic sign post, South, .5'.

Distance to lake, South, 57'.

Distances to nail in side of BTs.

Stump blaze scribed "BT".

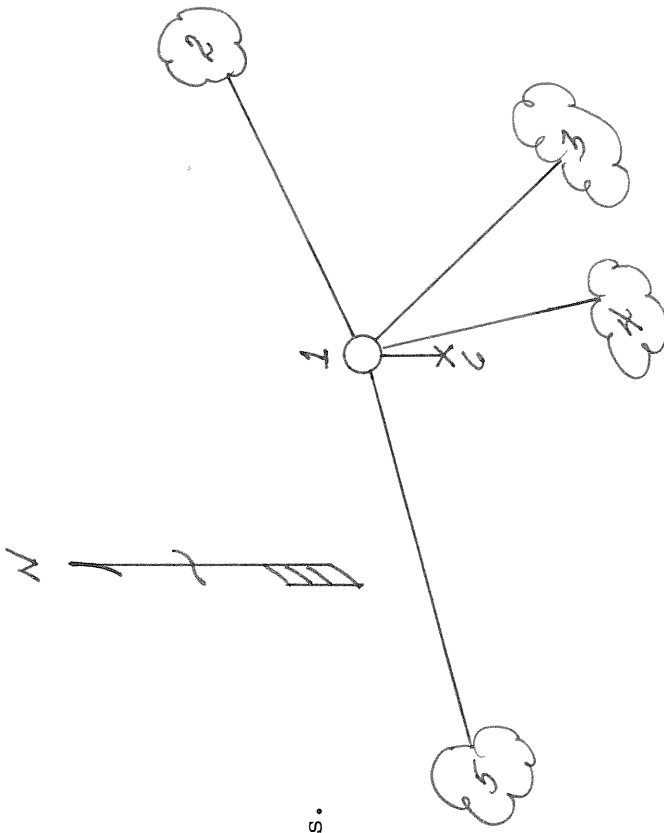

(i) I, Milo E. Stefan

(type or print name) certify that the corner location on this record was determined by me or under my direction and control and that this U.S. Public Land Survey Monument Record is correct and complete to the best of my knowledge and belief.

Milo E. Stefan

Signature

July 15, 1992

Date



Index No. L-5

Stamp