


# U.S. PUBLIC LAND SURVEY MONUMENT RECORD

Note: This form is intended and designed to fulfill all requirements of Wisconsin Administrative Code, Chapter A-E 7.08 U.S. Public Land Survey Monument Record (3) (a) (b) (c) (d) (e) (f) (g) (h) (i). An additional sheet may be added if necessary to conform with said requirements.

(a) Corner location: Township 31 North

Range 14 East/West

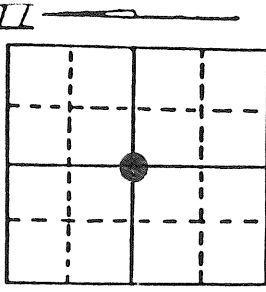

Section 18

Town/City/Village Wolf River

County Langlade

(b) (f) (g) (h) Description of monument found at this corner and if it was accepted, state all evidence (material, testimonial, occupational, plats, records, other monuments) used as a basis for accepting. If not accepted or if nothing was found, state evidence used as basis for establishing location. If reestablished through lost corner proportionate methods, indicate all monuments, distances and directions used to establish. Indicate type of monument found or set and sign post.

11/16/1913 - Brooks subdivided Section 18 by running the East - West and North - South Quarter lines. He set a wood post for Center Quarter Corner and one BT: 16" Yellow Birch, N31½°E, 11.5 Links (7.59')

Distance he had from: Center Quarter to North Quarter = 2561.46'  
Center Quarter to South Quarter = 2600.40'  
Center Quarter to West Quarter = 2572.68'  
Center Quarter to East Quarter = 2556.51'

7/13/1992 - Milo E. Stefan ran traverse from South Quarter to North Quarter and found Brook's BT remains with fence corner lying on ground. We positioned Center Quarter from BT, and found distances from:  
Center Quarter to North Quarter = 2565.54'  
Center Quarter to East Quarter = 2552.61'  
Center Quarter to South Quarter = 2602.51'  
Center Quarter to West Quarter = 2569.80'


We placed a 2" x 42" aluminum monument in mound of stone with three BTs.

(c) (d) (e) Plan view of corner with ties to at least 4 witness monuments. If in disagreement with previously established corner, show the distances between the two corners and also indicate the ties to the disputed corner.

- 1) 2" x 42" Aluminum monument in mound of stone.
- 2) 10" Hemlock, N46°E, 25.74'.
- 3) 6" Sugar Maple, S70°W, 37.47'.
- 4) 10" Sugar Maple, N5°W, 29.23'.

Distances to nail in side of BTs.

Stump blaze scribed "BT".

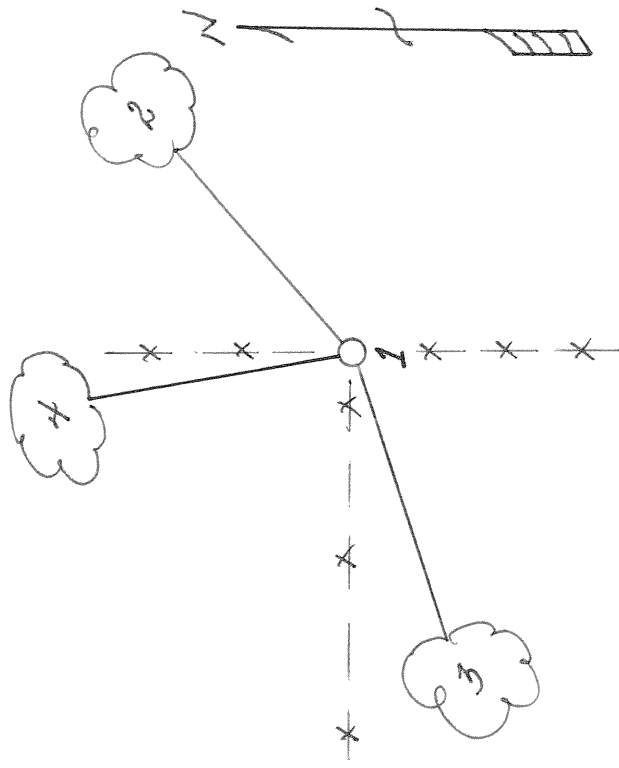

(i) I, Milo E. Stefan

(type or print name) certify that the corner location on this record was determined by me or under my direction and control and that this U.S. Public Land Survey Monument Record is correct and complete to the best of my knowledge and belief.

*Milo E. Stefan*

Signature

July 15, 1992

Date



Index No. L-3

Stamp