

CERTIFIED LAND CORNER RESTORATION


Index No. K-2

State of Wisconsin }
 County of LANGLADE } ss.

I WILLIAM F. KELLY, do hereby certify that on the 2nd day of MAY, 1979, I found evidence of the NW 1/16 corner of SECT 18 Township 31, North, Range 14 E, Fourth Principal Meridian, as described hereon; and that from this evidence I established a new monument and accessories as described hereon to perpetuate the original location of this corner.

Resident witnesses:

.....

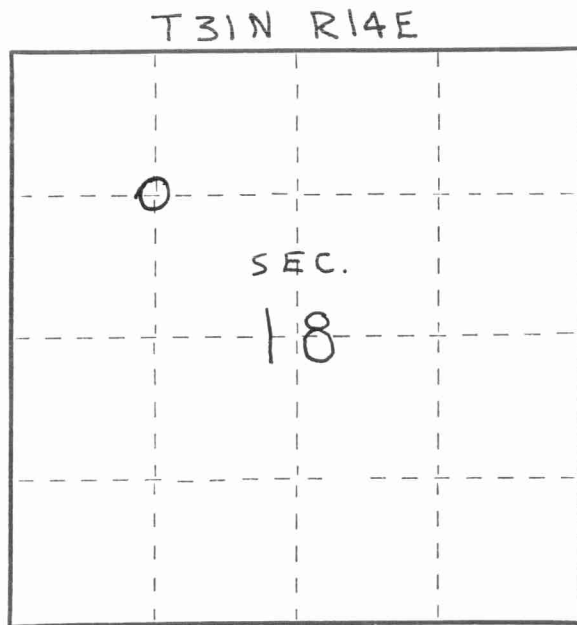

○ = Corner monument restored.

History of original corner establishment:

Description of corner evidence found:


CORNER ESTABLISHED FROM SURVEY OF NW 1/4 SECT 18



W.F. Kelly

VOID 12/93 DT

Description of monument and accessories I established to perpetuate the original location of this corner.

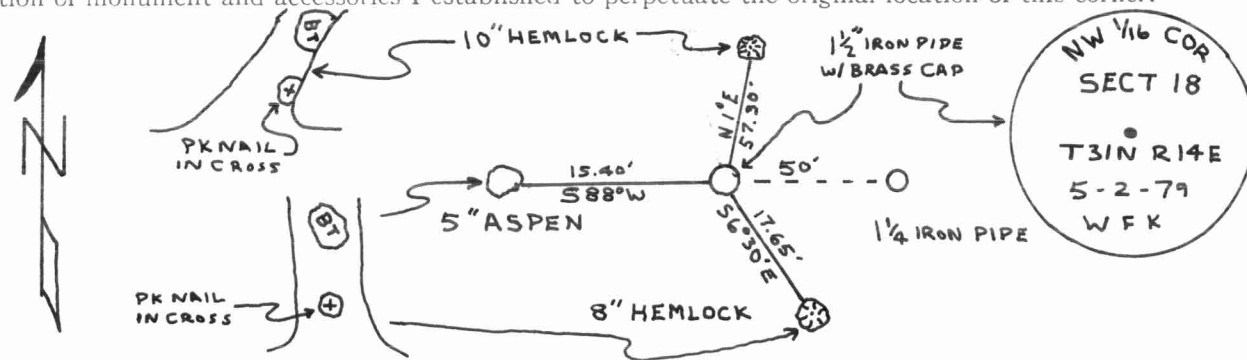

Dated at ELCHO, Wis., this 2 day of MAY, 1979.

Signature William F. Kelly Title COUNTY SURVEYOR Registration No. S-1098
 (County Surveyor, Registered Land Surveyor, or other duly authorized official)

Office of Register of Deeds, County of _____, I hereby certify that the within instrument was filed in this office for record on the _____ day of _____, 19____ at _____ o'clock _____ M.

(Register of Deeds)

By _____ Deputy

