

CERTIFIED LAND CORNER RESTORATION

31-14

Index No. N-0-8


State of Wisconsin }  
 County of LANGLADE } ss.

I, ROBERT J. POSS, do hereby certify that on the 26<sup>TH</sup> day of MAY, 19 70, I found evidence of the MEANDER COR. corner of E. 1/16 LINE NE 1/4 SEC. 20 Township 31, North, Range 14 EAST, Fourth, Principal Meridian, as described hereon; and that from this evidence I established a new monument and accessories as described hereon to perpetuate the original location of this corner.

History of original corner establishment:

Description of corner evidence found:

FOUND 1" PIPE (IRON) BESIDE REMAINS OF SQUARED STAKE.

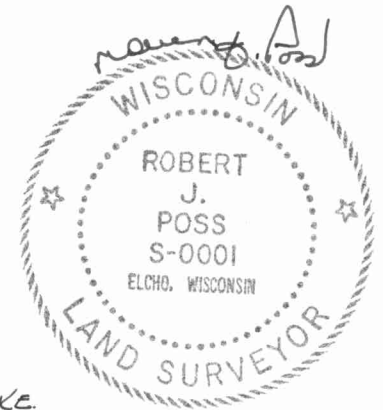


Resident witnesses:

.....  
 .....  
 .....

Description of monument and accessories I established to perpetuate the original location of this corner.

SET 1 1/4" IRON PIPE PAINTED ORANGE MKD. MEA. COR  
E 1/16 LINE NE 1/4  
SEC. 20  
T 34 N R 14 E

TREES NOT BLAZED  
 OR SCRIBED

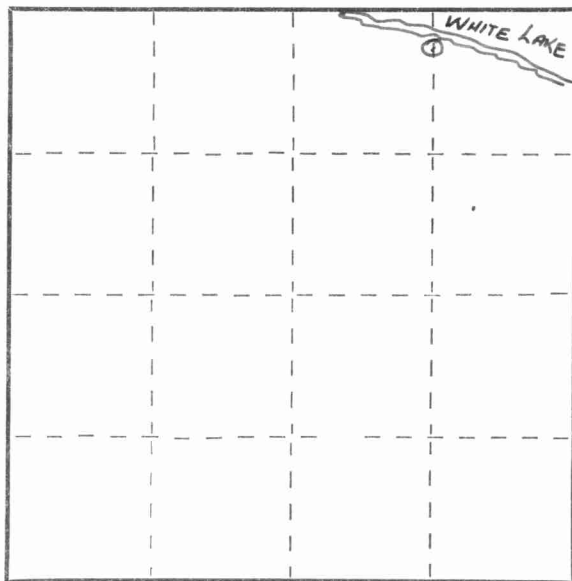

Dated at ELCHO, Wis., this 28<sup>TH</sup> day of MAY, 19 70.

Signature Robert J. Poss Title REG. LAND SURVEYOR Registration No. S-0001  
 (County Surveyor, Registered Land Surveyor, or other duly authorized official)

Office of Register of Deeds, County of \_\_\_\_\_, I hereby certify that the within instrument was filed in this office for record on the \_\_\_\_\_ day of \_\_\_\_\_, 19 \_\_\_\_\_ at \_\_\_\_\_ o'clock \_\_\_\_\_ M.

.....  
 (Register of Deeds)

By \_\_\_\_\_ Deputy

○ = Corner monument restored.

