


U.S. PUBLIC LAND SURVEY MONUMENT RECORD

Note: This form is intended and designed to fulfill all requirements of Wisconsin Administrative Code, Chapter A-E 5.02, U.S. Public Land Survey Monument Record (3) (a) (b) (c) (d) (e) (f) (g) (h) (i). -An additional sheet may be added if necessary to conform with said requirements.

(a) Corner location: Township 31 North

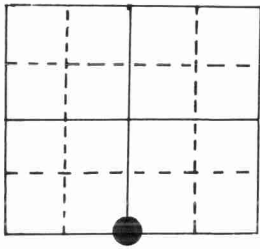

Section 22

Range 14 East ~~West~~

Town/~~City~~ Langlade Wolf River

County Langlade

brass cap in concrete flush in grass


(b) (f) (g) (h) Description of monument found at this corner and if it was accepted, state all evidence (material, testimonial, occupational, plats, records, other monuments) used as a basis for accepting. If not accepted or if nothing was found, state evidence used as basis for establishing location. If reestablished through lost corner proportionate methods, indicate all monuments, distances and directions used to establish.

Original by J. McBride, 1857, OBT's BW 6" S65°E 10 lks., Lind 14" N52°W 24 lks.

Robert Poss, 6/25/68, set mon. M. Skorie, owner of adjacent property since 1919 showed approx. location of cor. Found squared stake under fill - badly rotted-lying on side - stub down. Did not find pipe.

Seymour, 1986, found brass cap in conc. and made mor references.

(c) (d) (e) Plan view of corner with ties to at least 4 witness monuments. If in disagreement with previously established corner, show the distances between the two corners and also indicate the ties to the disputed corner.

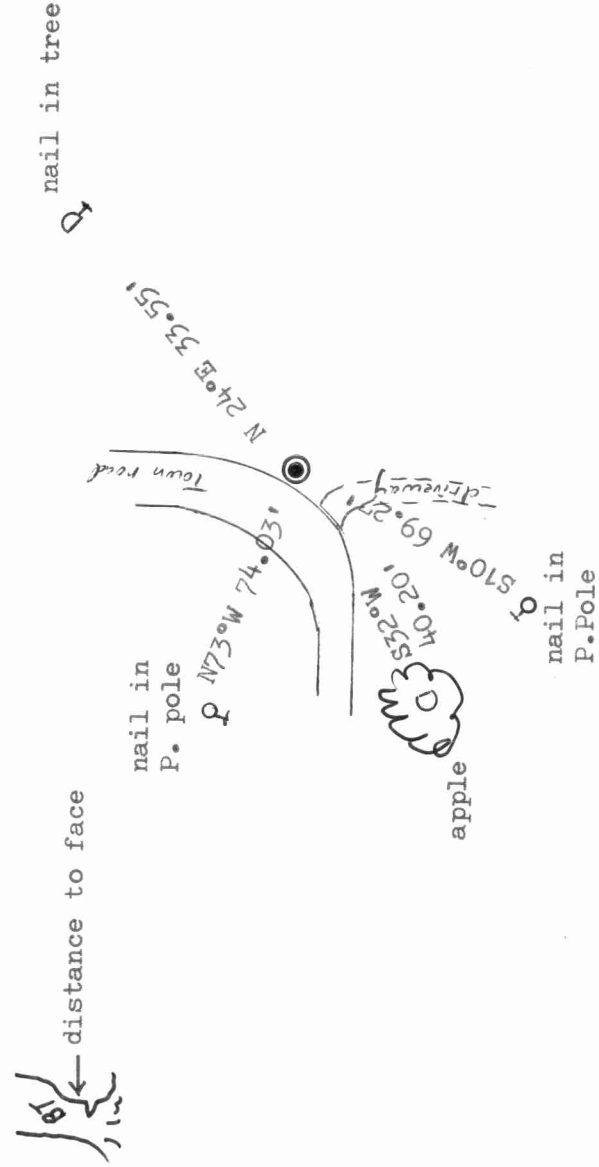

(i) I, Marvin E. Seymour

(type or print name) certify that the corner location on this record was determined by me or under my direction and control and that this U.S. Public Land Survey Monument Record is correct and complete to the best of my knowledge and belief.

Signature Marvin E. Seymour Date June 19, 1986

William G. Kelly Co. Surveyor Ver. & Rec. Cut-6/25/86

