

4311429 0000 1986

# U.S. PUBLIC LAND SURVEY MONUMENT RECORD


Note: This form is intended and designed to fulfill all requirements of Wisconsin Administrative Code, Chapter A-E 5.02, U.S. Public Land Survey Monument Record (3) (a) (b) (c) (d) (e) (f) (g) (h) (i). An additional sheet may be added if necessary to conform with said requirements.

(a) Corner location: Township 31 North

Range 14 East ~~West~~

Town/City ~~Village~~ Wolf River

County Langlade

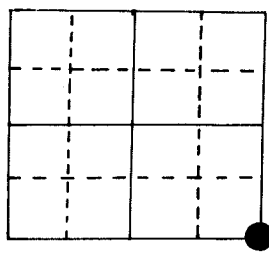

Section 28


2" aluminum pipe w/Langlade Co. cap

(b) (f) (g) (h) Description of monument found at this corner and if it was accepted, state all evidence (material, testimonial, occupational, plats, records, other monuments) used as a basis for accepting. If not accepted or if nothing was found, state evidence used as basis for establishing location. If reestablished through lost corner proportionate methods, indicate all monuments, distances and directions used to establish.

Original by J. McBride, 1857, OBT's Heml 12" N41°W 19 lks., Heml 6" N5°E 5 lks., Heml 18" S35°W 10 lks., Heml 6" S38°E 25 lks.

Seymour, 11/12/85, found 1 1/2" well point on edge of woods trail. Local land owner, Allen Kahn said well point has been there at least 60 yrs. and thinks his grandfather put it there in place of the original post. His grandfather did surveying in the area.  
Well point was replaced with a Co. aluminum mon. on 4/30/ 86.

(c) (d) (e) Plan view of corner with ties to at least 4 witness monuments. If in disagreement with previously established corner, show the distances between the two corners and also indicate the ties to the disputed corner.

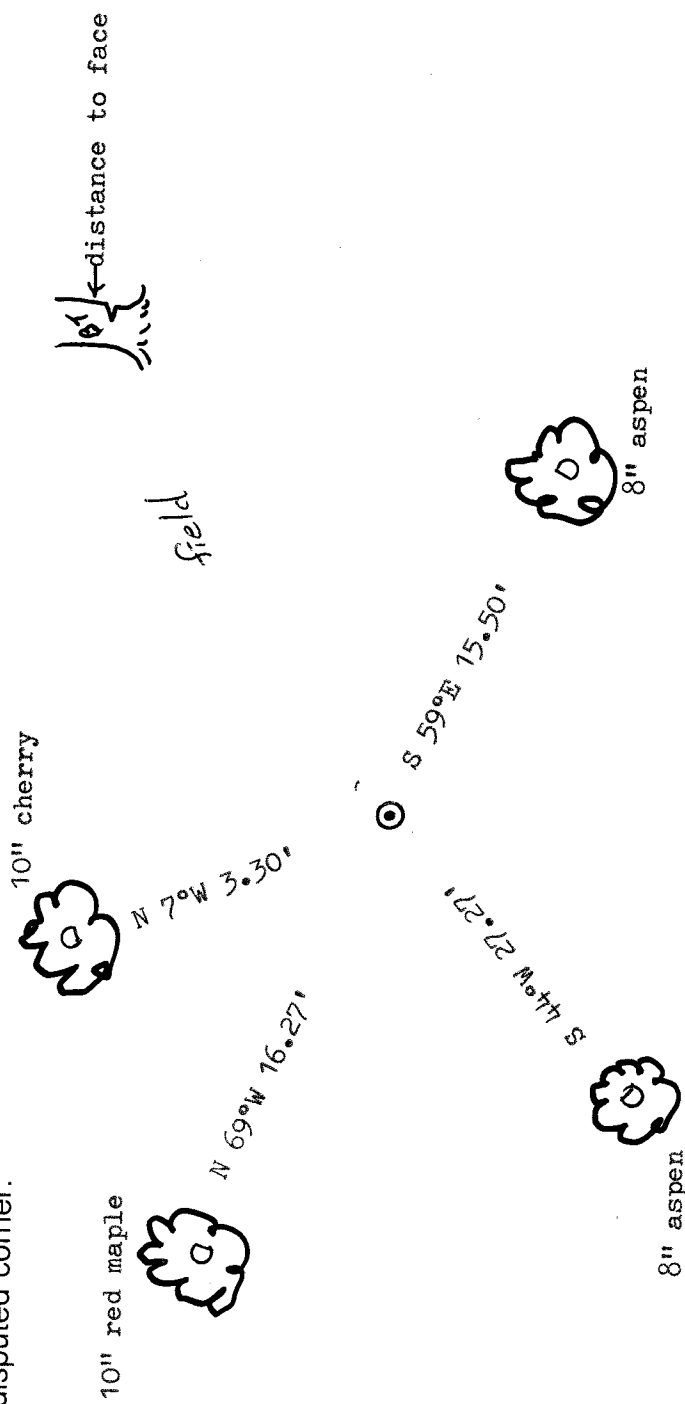


(f) I, Marvin E. Seymour

(type or print name) certify that the corner location on this record was determined by me or under my direction and control and that this U.S. Public Land Survey Monument Record is correct and complete to the best of my knowledge and belief.

Signature Marvin E. Seymour Date June 19, 1986

William J. Kelly Co. Surveyor Wisconsin 6/2-3/86

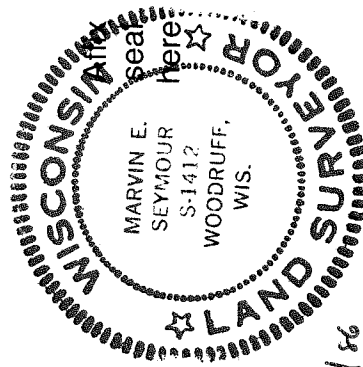

V-9