

U. S. PUBLIC LAND SURVEY MONUMENT RECORD Z-3


I N S T R U C T I O N S :

This record shall show the location of the corner and shall include all of the following nine elements (a through i).

- (a) Identify the corner by reference to the U.S. public land survey system.
 ○ = Corner monument restored.

Sec. 31, T31N, R14E
Town of Wolf River
Langlade Co.

2" iron pipe w/brass cap

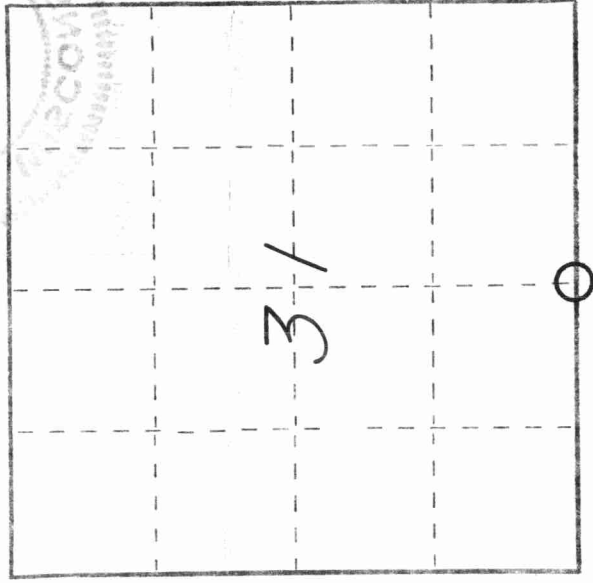

- (b) Describe any record evidence, monument evidence, occupational evidence, testimonial evidence, or any other material evidence you considered, and whether the monument was found or placed.

Monument found in place, set from U.S. General Land Office dependent resurvey dated Sept. 8, 1933, using orig. BTs.

Orig. BTs found 1933

MH 30" stp N15°E 90 lks
 stp hole N57°E 56 lks

New BTs made 1933

MH12" N55°E 68 lks
 Elm 5" N10°W 49½ lks

Orig. GLO survey, 1857
 Orig. BTs (gone)


BW 30" N57°E 56 lks
 MH15" N15°E 90 lks
 MH10" N28°W 31 lks
 MH10" N29°W 15 lks

Guy R. Veal, U.S. Cadastral Engineer

In 1983 all these BTs are gone.

- (c) In the plan view drawing below, provide reference ties to at least 4 witness monuments, or, if the location is within a municipality, to at least 2 witness monuments. (Witness monuments shall be made of concrete, natural stone, iron or other equally durable material.)
 Describe witness monuments.

- (d) Show a plan view drawing depicting the relevant monuments and reference ties which is sufficient in detail to enable accurate relocation of the corner monument if the corner monument is disturbed. Indicate north.

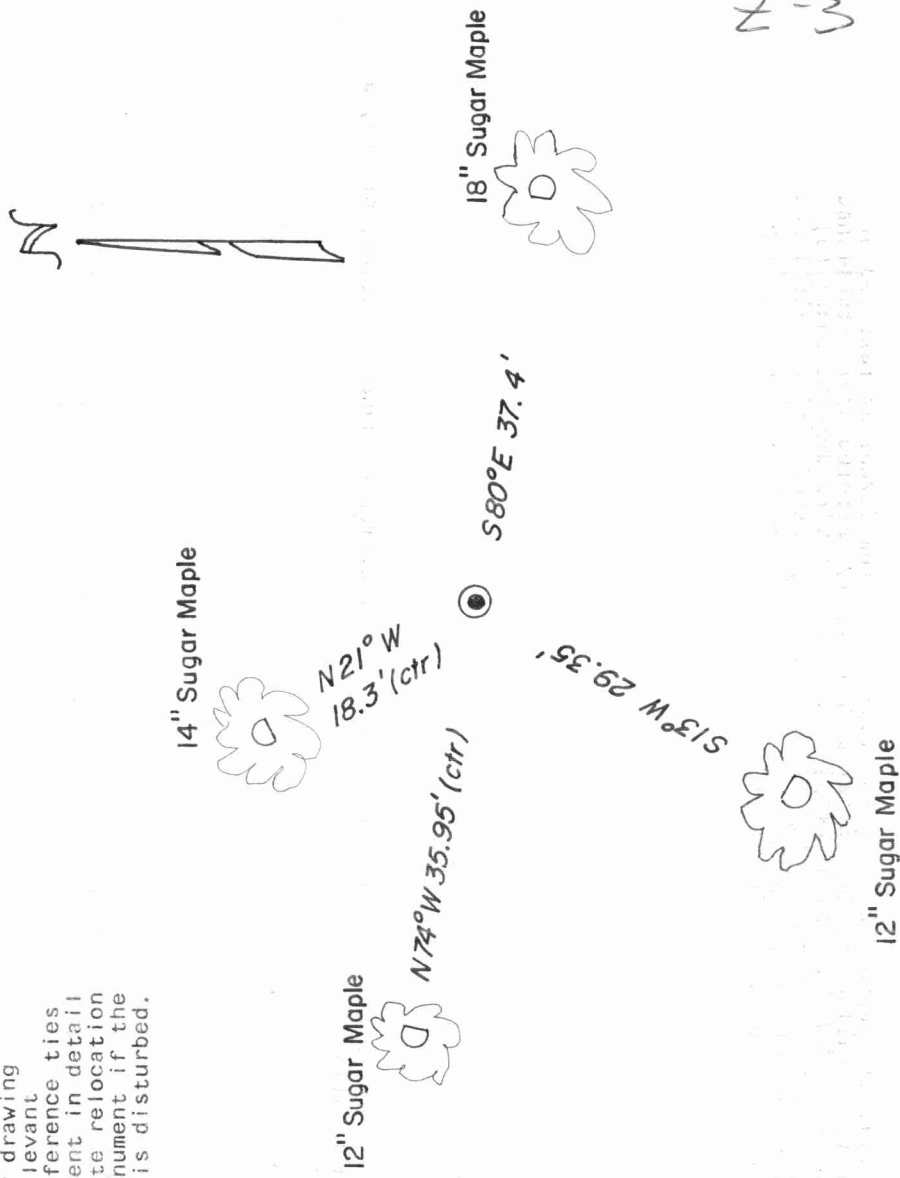

(e) Describe any material discrepancy between the location of the corner as restored or reestablished and the location of that corner as previously restored or reestablished by distance and direction. Show the discrepancy on the plan view drawing under (d), above. Show the distances between the corner as previously restored or reestablished and (1) the corner as restored or reestablished, and (2) to at least 2 of the witness monuments shown on the drawing in (d), above.

None

(f) Was the corner restored through acceptance of (1) an obliterated evidence location, or, (2) a found perpetuated location?

NO

(g&h) Was the corner reestablished through lost corner proportionate methods? If so, show the method, including the directions and distances to other public land survey corners used as evidence or used for proportioning in determining the corner location?

NO

(i) I, Marvin E. Seymour D.N.R.
Rt. 1, Box 45
Boulder Jct. WI 54512
(type or print name) certify that the corner location shown on this record was determined by me or under my direction and control and that this U.S. Public Land Survey Monument Record is correct and complete to the best of my knowledge and belief.

Marvin Seymour
Signature

April 5, 1983
Date

