


U.S. PUBLIC LAND SURVEY MONUMENT RECORD

Note: This form is intended and designed to fulfill all requirements of Wisconsin Administrative Code, Chapter A-E 5.02, U.S. Public Land Survey Monument Record (3) (a) (b) (c) (d) (e) (f) (g) (h) (i). -An additional sheet may be added if necessary to conform with said requirements.

(a) Corner location: Township 31 North

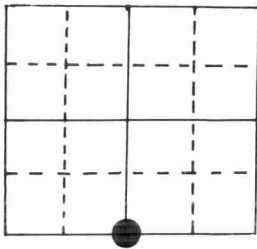

Section 34

Range 14 East ~~14~~

Town/~~City/Village~~ Wolf River

County Langlade

PK nail

(b) (f) (g) (h) Description of monument found at this corner and if it was accepted, state all evidence (material, testimonial, occupational, plats, records, other monuments) used as a basis for accepting. If not accepted or if nothing was found, state evidence used as basis for establishing location. If reestablished through lost corner proportionate methods, indicate all monuments, distances and directions used to establish.

Original, 1857, J. McBride, OBT's Ironwood 6" S75°W 19 lks., BW 12" S40°E 16 lks.


PK nail probably set by W. Tradewell in 1978.

Seymour, 1985, found PK nail and accepted the location as distances east and west from it checked good.

(c) (d) (e) Plan view of corner with ties to at least 4 witness monuments. If in disagreement with previously established corner, show the distances between the two corners and also indicate the ties to the disputed corner.



distance to face

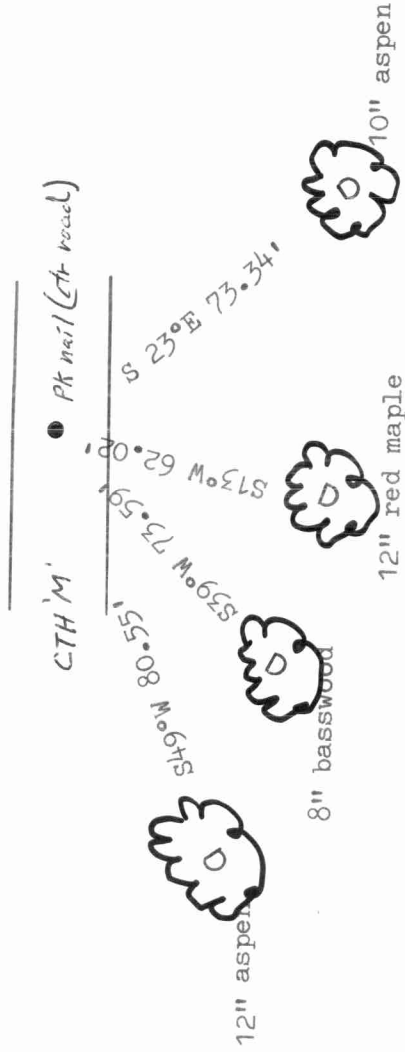

(i) Marvin E. Seymour

(type or print name) certify that the corner location on this record was determined by me or under my direction and control and that this U.S. Public Land Survey Monument Record is correct and complete to the best of my knowledge and belief.

Marvin E. Seymour 2/28/86

Signature

Date

