

4311434000

U.S. PUBLIC LAND SURVEY MONUMENT RECORD

(Prepared and as required by S. A-E 7.08 Wi Administrative Code)
 The Southwest corner of Section 35, T. 31N., R14E., Langlade County, WI

Corner was: (check all that apply)

- Restored through acceptance of an obliterated evidence location.
- Restored through acceptance of a found perpetuated location.**
- Determined to be lost and reestablished through proportionate methods.
 (Show bearings and distances to PLSS corners used for proportioning)
- Restored/recovered/reestablished in a location that differs from a previously established position. (Show difference in plan view below.)
- Check here if additional information is shown on the reverse side of this form.

Describe record evidence, recovered physical evidence, occupational evidence, testimonial evidence and all other evidence considered in the recovery/restoration of corner.

1851: J.M. Marsh set a post for the corner of sections 34 and 35. BT's Sugar Maple 14"; N 73° E, 44 links; Hemlock 12" N 65° E, 46 links; Hemlock 9", N 09° W, 29 links; Hemlock 16", N 65° W, 12 links.

1933: GLO Dependent Resurvey found corner from original bearing trees. Set a 24" concrete monument with a brass tablet. New BT's: Hemlock 6", N 42 ½° E, 68 ½ links; Hemlock 12" N 53° W 44 ½ links.

September 2005: Tim Rusch, Paul Mattmiller, and Dave Tlusty, found concrete monument in place found Hemlock BT (now 14") N 42° E, 45.0' and a Hemlock BT (now 16") N 53° E, 29'. Found decayed stump of original BT's.


Physical description of the monument set:

Left monument in place and tied as follows.

Describe the accessories used to perpetuate the location of the corner. Include a plan view drawing and indicate accessories found/set. Describe measuring point on bearing trees. Show any topographic features that would aid in future recovery of the corner.

Bt's are blazed and marked with aluminum Bt tag.
 Distances measured to aluminum nail on right side base of tree.

- ① N 87° E 46.37'
- ② N 19° W 6.06'
- ③ S 29° W 18.59'
- ④ N 33° E 19.36'
- ⑤ White plastic T post 0.75' North

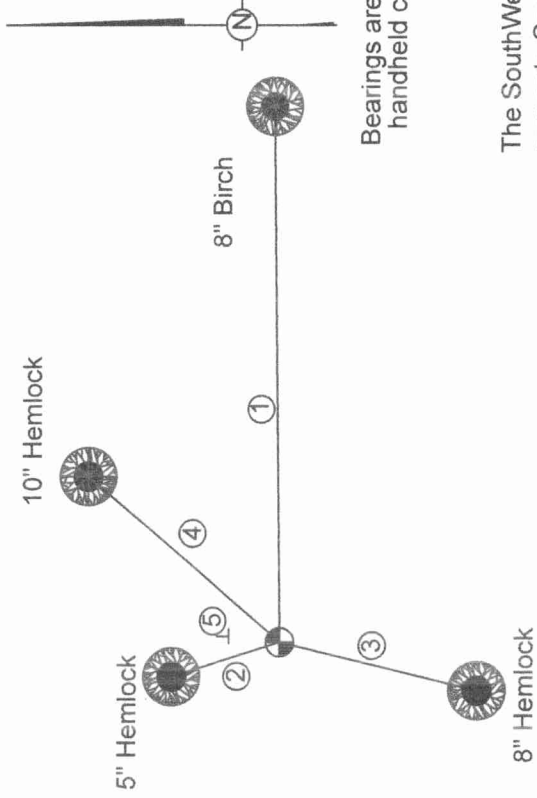


NOT TO SCALE

DRAFTED BY:
 PAUL MATTMILLER

I, Timothy J. Rusch RLS 2671, certify that the corner location shown on this record was determined by me or under my direction and control and that this U.S. Public Land Survey Record is correct and complete to the best of my knowledge and belief.

Timothy J. Rusch
 Signature 11-15-2005
 Date

SURVEYOR'S SEAL

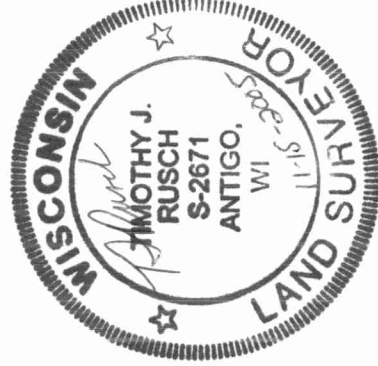

The SouthWest corner to Section 35
 T. 31 N., R. 14 E.
 Langlade County, WI

