

U.S. PUBLIC LAND SURVEY MONUMENT RECORD

(Prepared and as required by S. A-E 7.08 WI Administrative Code)

The SW corner of Section 36, T. 31 N., R. 14 E., Langlade County, WI

Corner was: (check all that apply)

- Restored through acceptance of an obliterated evidence location.
- Restored through acceptance of a found perpetuated location.
- Determined to be lost and re-established through proportionate methods.
(Show bearings and distances to PLSS corners used for proportioning.)
- Restored/recovered/reestablished in a location that differs from a previously established position. (Show difference in plan view below.)

- Check here if additional information is shown on the reverse side of this form.

Describe record evidence, recovered physical evidence, occupational evidence, testimonial evidence and all other evidence considered in the recovery/restoration of the corner.

1851-- S.LINE OF TWP. BY JAMES MARSH, W. ON S. LINE OF SEC.36 ,80.0 CHS. SET POST FOR SEC'S. 35 & 36, B.Ts--BURR OAK 10" N.48°E. 33 LKS., ELM 11" N.22E. 23 LKS., DO 10" N.39°W. 20 LKS., DO 8"N.69°W. 37 LKS.
1933--GUY VEAL SURVEYOR FOR U.S. GENERAL LAND OFFICE, SET CONC. MON. WITH BRASS CAP STAMPED TO IDENTIFY CORNER

1990--KELLY R.L.S.# S-1098, FOUND CONC. MONUMENT WITH BRASS CAP--B.Ts-- 10" MAP. N.88°E. 33.11, 3" MAP. S.24°E. 14.84, 14" HEM. S.77°W. 28.22, 14" YEL. BIR. N.52°W. 4.07.
1999--DOBBRATZ R.L.S. # S-973, FOUND 6" DIA. CONC. MON. WITH BRASS CAP ON GROUND NEAR FENCE COR. ALL B.Ts IN TACT.

Physical description of the monument set:

REPLACED FOUND 6" DIA. CONC. MON. WITH BRASS CAP AT KELLY'S TIES, USED BEST FIT AS PER EXISTING TIES (SOME WERE NOT AS ORIGINAL TIES)


Describe the accessories used to perpetuate the location of the corner. Include a plan view drawing and indicate accessories found/set. Describe measuring point on bearing trees. Show any topographic features that would aid in future recovery of the corner.

EXISTING & NEW ACCESSORIES

- ① B.T. 12" MAP. N.88°E. 33.11FT. (EXISTING, NEW NAIL PLACED OVER OLD)
- ② B.T. 5" MAP. S.28°E. 14.68FT. (EXISTING, NEW NAIL PLACED)
- ③ B.T. 16" HEM. S.72°W. 28.22FT. (EXISTING, P.K. NAIL FOUND)
- ④ B.T. 16" YEL. BIR. N.56°W. 4.07FT. (EXISTING, P.K. NAIL FOUND)

- ⑤ SW COR. OF SEC. 36, REPLACED EXISTING 6" DIA. CONC. MON. WITH BRASS CAP AT BEST FIT FROM B.Ts.

SET PLASTIC POST WITH SURVEY MARKER STICKER 2FT. S. OF CORNER, BEARINGS ARE MAGNETIC & ARE TAKEN TO THE CENTER OF B.Ts, DIMENSIONS ARE TO A NAIL ON THE SIDE OF B.Ts, ALL B.Ts WERE BLAZED, PAINTED BLUE & ALUM. B.T. TAGS WERE PLACED ON B.Ts.

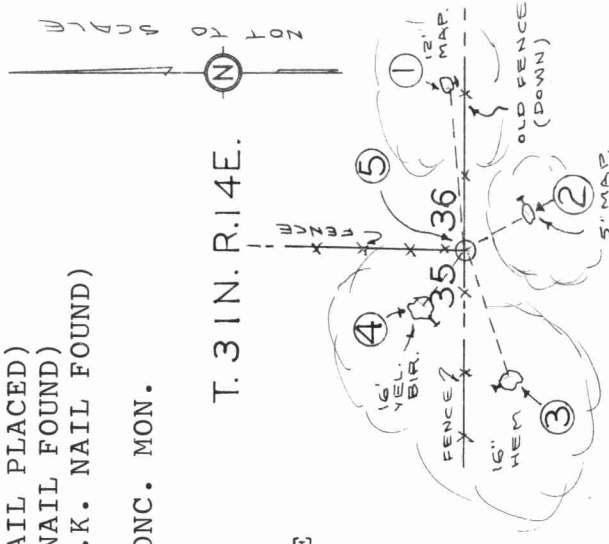

MENOMINEE RES.


The SW corner of Section 36
SURVEYORS SEAL



I, W.G. DOBBRATZ, certify that the corner location shown on this record was determined by me or under my direction and control and that this U.S. Public Land Survey Monument Record is correct and complete to the best of my knowledge and belief.

Wayne G. Dobbratz 4/18/99
Signature Date

INDEX No. Z-21

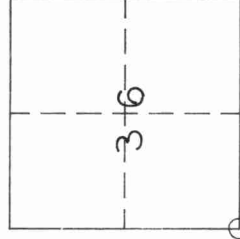

O = Location of corner