


U. S. PUBLIC LAND SURVEY MONUMENT RECORD

I N S T R U C T I O N S :

This record shall show the location of the corner and shall include all of the following nine elements (a through i).

- (a) Identify the corner by reference to the U.S. public land survey system.
 O = Corner monument restored.

Quarter corner to Sections 19 and 30, T.31N., R.15E.

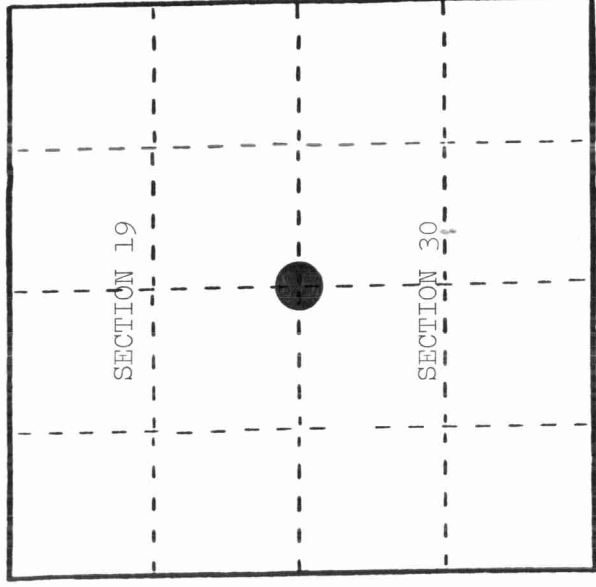


T 3 1 N R 1 5 E

- (b) Describe any record evidence, monument evidence, occupational evidence, occupational evidence, testimonial evidence or any other material evidence you considered, and whether the monument was found or placed.

1857, James McBride set wood post at 44.00 chains with the following BTs: Birch, 12", S.5°E., 8 links; Hemlock, 8", S.86°W., 16 links.

August 1, 1984, Milo Stefan found 1" x 12" iron bar in road 3" below surface; centerline of road west, old fence east and +30 years old fence south; BTs fall in road.

- (c) In the plan view drawing below, provide reference ties to at least 4 witness monuments, or, if the location is within a municipality, to at least 2 witness monuments. (Witness monuments shall be made of concrete, natural stone, iron or other equally durable material.)
 Describe witness monuments.

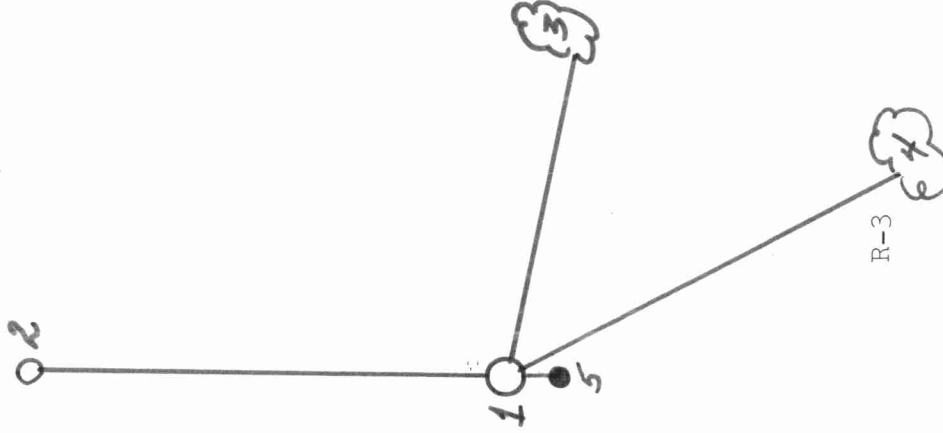

1. 2" x 36" aluminum monument stamped to identify the corner.
2. Power Pole, W PL D 31-15-19, North, 169.75 feet
3. Red Pine, 9", S.81°E., 30.66 feet
4. Red Pine, 10", S.37°E., 64.27 feet
5. Steel Sign Post, South, 21.0 feet

(e) Describe any material discrepancy between the location of the corner as restored or reestablished and the location of that corner as previously restored or reestablished by distance and direction. Show the discrepancy on the plan view drawing under (d), above. Show the distances between the corner as previously restored or reestablished and (1) the corner as restored or reestablished, and (2) to at least 2 of the witness monuments shown on the drawing in (d), above.

None.

(f) Was the corner restored through acceptance of (1) an obliterated evidence location, or, (2) a found perpetuated location?

(2) a found perpetuated location.

(g&h) Was the corner reestablished through lost corner proportionate methods? If so, show the method, including the directions and distances to other public land survey corners used as evidence or used for proportioning in determining the corner location?

No.

CHECKED 6/7/85 M.E. JULLY S1098

(1) Milo E. Stefan

(Type or print name) certify that the corner location shown on this record was determined by me or under my direction and control and that this U.S. Public Land Survey Monument Record is correct and complete to the best of my knowledge and belief.

Milo E. Stefan
Signature

3/10/85

Date

Affix Land Surveyor Seal

