

# U. S. PUBLIC LAND SURVEY MONUMENT RECORD


**INSTRUCTIONS:**

This record shall show the location of the corner and shall include all of the following nine elements (a through i).

- (a) Identify the corner by reference to the U.S. public land survey system.
- O = Corner monument restored.

Standard corner to Sections 32 and 33, T.31N., R.15E.

RECORDED IN OCONTO CO. R.D.D  
 DOC. # 355244

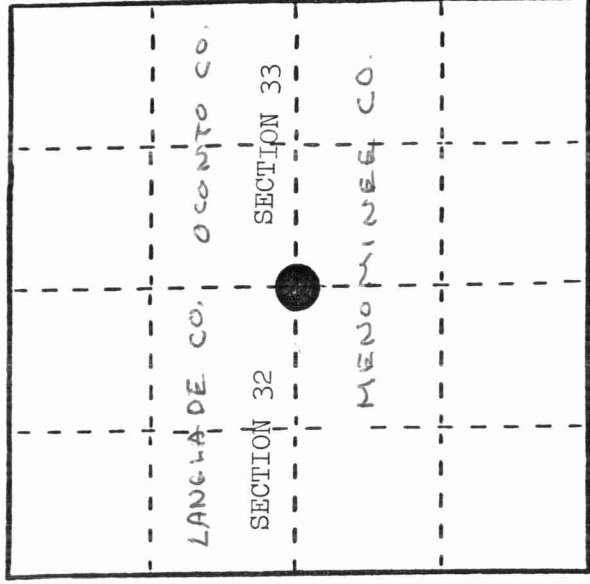

- (b) Describe any record evidence, monument evidence, occupational evidence, testimonial evidence or any other material evidence you considered, and whether the monument was found or placed.

In 1933, G. Veals, on dependent resurvey of the 3rd correction line, set this corner by single proportion and made the following BTs: White Pine, 10", N.79°E., 125 links; Poplar, 8", N.42 1/2°W., 114 links.


In 1974, Jean Resvick found corner as per Veals. Poplar BT now a stump.

In 1985, L. Scheuerman and D. Huettl found corner as described by Resvick and made new references:

- (c) In the plan view drawing below, provide reference ties to at least 4 witness monuments, or, if the location is within a municipality, to at least 2 witness monuments. (Witness monuments shall be made of concrete, natural stone, iron or other equally durable material.) Describe witness monuments.

- (d) Show a plan view drawing depicting the relevant monuments and reference ties which is sufficient in detail to enable accurate relocation of the corner monument if the corner monument is disturbed. Indicate north.

1. 6" x 6" concrete monument set by Veals
2. White Pine, 10", N.81°E., 68.61 feet
3. White Pine, 10", S.9°E., 45.53 feet
4. White Pine, 10", S.43°W., 86.78 feet
5. White Pine, 8", N.54°W., 77.84 feet
6. Steel Sign Post, East, 1.20 feet

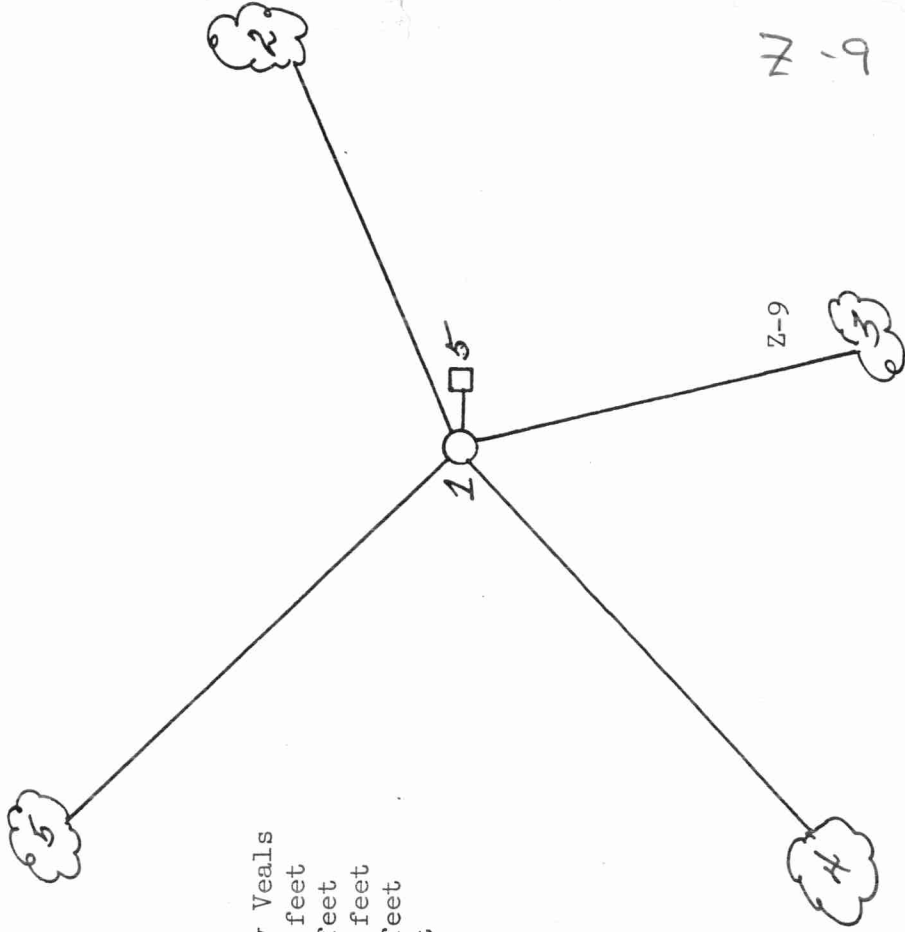

(1) Describe any material discrepancy between the location of the corner as restored or reestablished and the location of that corner as previously restored or reestablished by distance and direction. Show the discrepancy on the plan view drawing under (d), above. Show the distances between the corner as previously restored or reestablished and (1) the corner as restored or reestablished, and (2) to at least 2 of the witness monuments shown on the drawing in (d), above.

No.

(f) Was the corner restored through acceptance of (1) an obliterated evidence location, or, (2) a found perpetuated location?

(2) a found perpetuated location.

(g&h) Was the corner reestablished through lost corner proportionate methods? If so, show the method, including the directions and distances to other public land survey corners used as evidence or used for proportioning in determining the corner location?

No.

(1) *Milo E. Stefan*  
Signature  
Date *1/11/86*

Affix Land Surveyor Seal



*William D. Kelly Co. Surveyor Central National 6-23-86*