


U. S. PUBLIC LAND SURVEY MONUMENT RECORD

I N S T R U C T I O N S:

This record shall show the location of the corner and shall include all of the following nine elements (a through i).


- (a) Identify the corner by reference to the U.S. public land survey system.
- O = Corner monument restored.

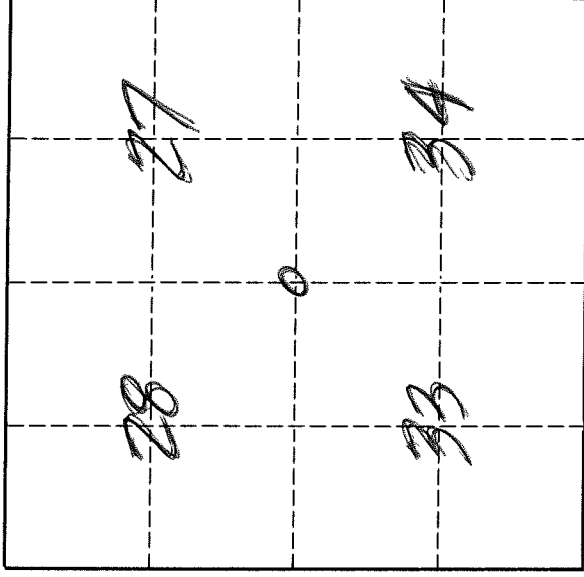

The Southwest corner of Section 27, Township 32 North, Range 11 East, Langlade County, Wisconsin.

T. 32 N., R. 11 E.

- (b) Describe any record evidence, monument evidence, occupational evidence, testimonial evidence or any other material evidence you considered, and whether the monument was found or placed.
The original corner was established in 1860 by Hiram C. Fellows. Original BT's: cherry, 8", S70°E, 15 lks., and a sugar, 12", S25°W, 19 lks. In 1903, Weby set a stone, 4" x 14" x 18" + on top. In 1938, Malcolm Hutchinson found stone in road, took stone out and set drive point for corner. In 1990, former surveyor Kelly set RR spike over existing iron in road. 07/29/96 D. Tlusty, M. Keilcheski found well (drive) point in road. Removed it and exactly replaced it with a 1½" x 36" iron pipe with 4" brass cap, top of which is 14" below road surface.
- (c) In the plan view drawing below, provide reference ties to at least 4 witness monuments, or, if the location is within a municipality, to at least 2 witness monuments. (Witness monuments shall be made of concrete, natural stone, iron or other equally durable material.)
Describe witness monuments.

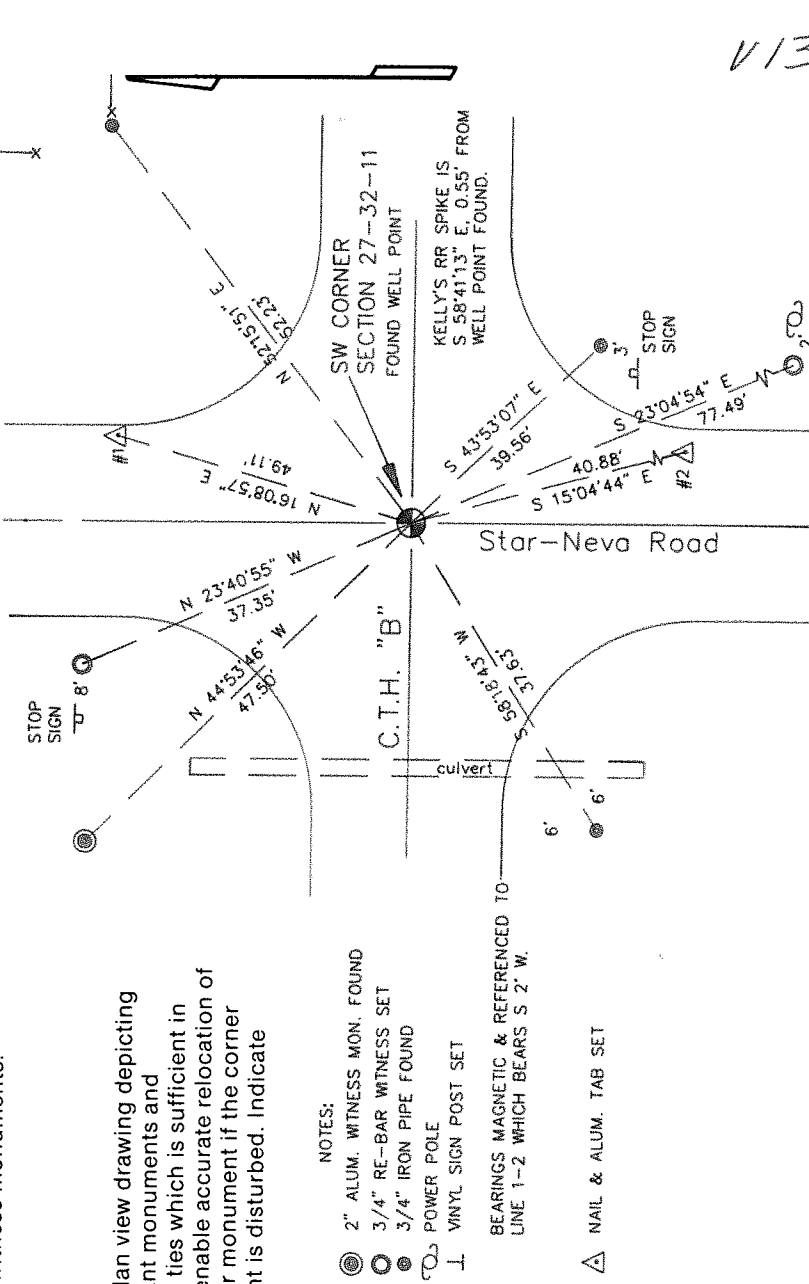

- NOTES:**
- ⊙ 2" ALUM. WITNESS MON. FOUND
 - ⊙ 3/4" RE-BAR WITNESS SET
 - ⊙ 3/4" IRON PIPE FOUND
 - ⊙ POWER POLE
 - ⊙ VINYL SIGN POST SET
 - BEARINGS MAGNETIC & REFERENCED TO LINE 1-2 WHICH BEARS S 2° W.
 - △ NAIL & ALUM. TAB SET

113

Describe any material discrepancy between the location of the corner as restored or reestablished and the location of that corner as previously restored or reestablished by distance and direction. Show the discrepancy on the plan view drawing under (d), above. Show the distances between the corner as previously restored or reestablished and (1) the corner as restored or reestablished, and (2) to at least 2 of the witness monuments shown on the drawing in (d), above.

See difference shown on tie sketch. Apparently Kelly didn't dig out the corner, but just picked a spot over the well point with a metal detector.

(f) Was the corner restored through acceptance of (1) an obliterated evidence location, or, (2) a found perpetuated location?
A found perpetuated location.

(g & h) Was the corner reestablished through lost corner proportionate methods? If so, show the method, including the directions and distances to other public land survey corners used as evidence or used for proportioning in determining the corner location.

No.

(i) I, David E. Tlusty, Langlade County Surveyor,

(type or print name)

certify that the corner location shown on this record was determined by me or under my direction and control and that this U.S. Public Land Survey Monument Record is correct and complete to the best of my knowledge and belief.

David E. Tlusty 8/6/96

Signature

Date

