LANGLADE COUNTY
U.S. PUBLIC LAND CORNER RESTORATION

The South quarter corner of Section 21, T. 31 N., R. 09 E., Langlade County, WI.

Corner was: (check all that apply) 4310921 0020

- ☐ Restored through acceptance of an obliterated evidence location.
- ☐ Restored through acceptance of a found perpetuated location.
- ☒ Determined to be lost and re-established through proportionate methods.
  Show bearings and distances to PLSS corners used for proportioning, and show original distances).
- ☐ Restored/recovered/re-established in a location that differs from a previously established position.
  (Show difference in plan view below).
- ☐ Check here if additional information is shown on the reverse side of this form.

Describe record evidence, recovered physical evidence, occupational evidence, testimonial evidence and all other evidence considered in the recovery/restoration of the corner.

The original corner was established in 1860 by Hiram Fellows. Original bearing trees: birch, 10", N41°W, 14 links and a fir, 7", S48°E, 10 links.
In 1919, Malcolm Hutchinson, made a survey of the highway running along the section line. He made no mention of this corner and measured this mile as 5245.68'. Baker (date unknown) also made a survey along the highway. By centerline stationing, he located section corners and culverts. Bakers distance along the South line of Section 21 was reported as 5190'. In 1920, the highway was surveyed for construction by G.C. Miles, surveyor. His notes show that the section and quarter corners were held as centerline PI's.
06/23/06 D. Tlusty. Re-established corner by single proportionate measure.

Physical description of the monument set:

I set a Berntsen SN-1 nail for the corner. Corner falls on approximate center of Hwy "64".

Describe the accessories used to perpetuate the corner. Include a plan view drawing and accessories found/set. Describe measuring point on bearing trees. Show any topographic features that would aid in future recovery of the corner.

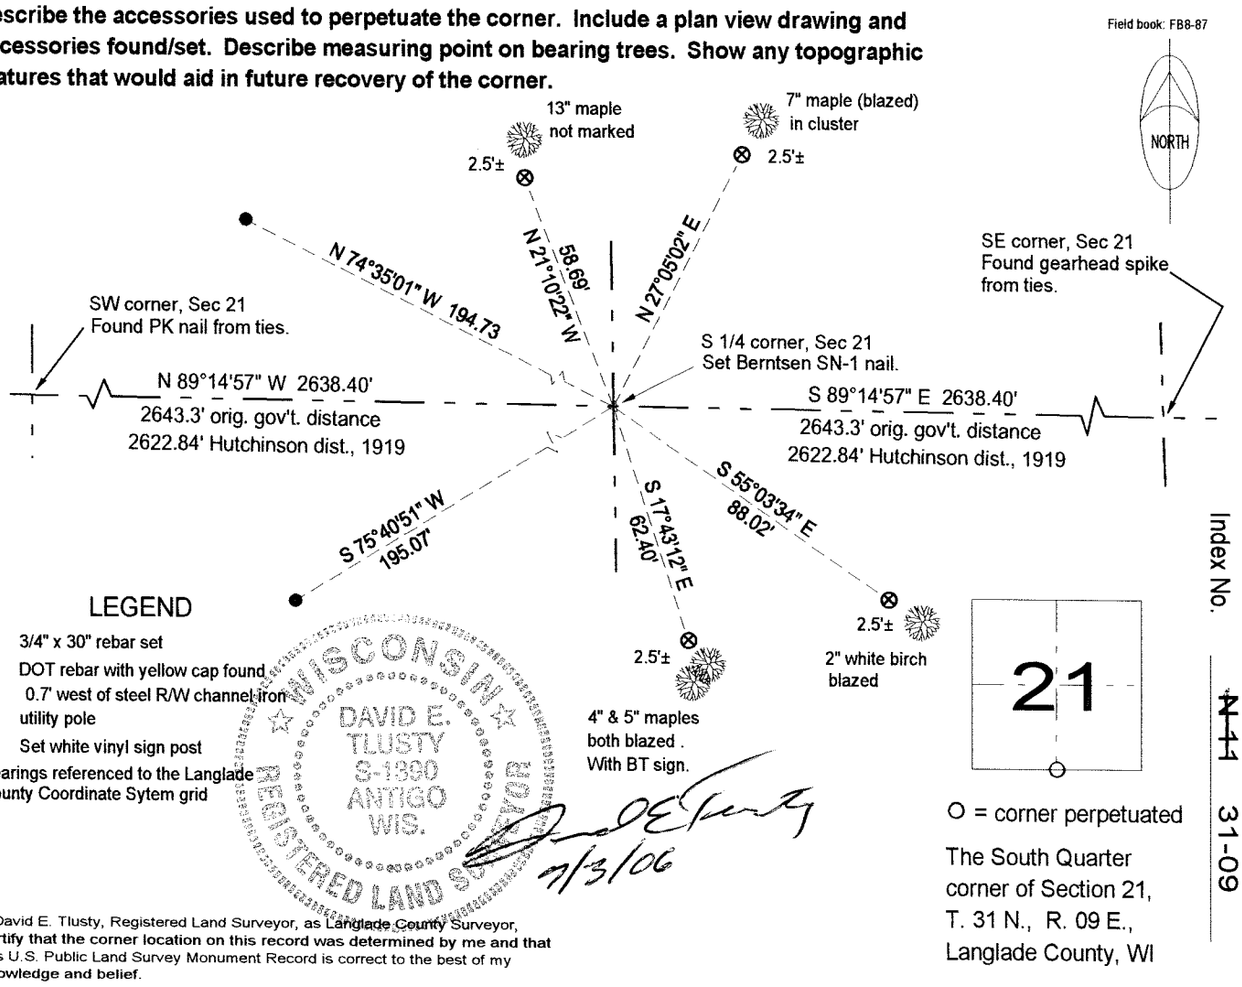

I, David E. Tlusty, Registered Land Surveyor, as Langlade County Surveyor, certify that the corner location on this record was determined by me and that this U.S. Public Land Survey Monument Record is correct to the best of my knowledge and belief.