43111270000

U. S. PUBLIC LAND SURVEY MONUMENT RECORD

INSTRUCTIONS: This record shall show the location of the corner and shall include all of the following nine elements (a through i).

(a) Identify the corner by reference to the U.S. public land survey system.

● = Corner monument restored.

The Southwest corner of
Section 26,
Township 31 North,
Range 11 East,
Langlade County,
Wisconsin.

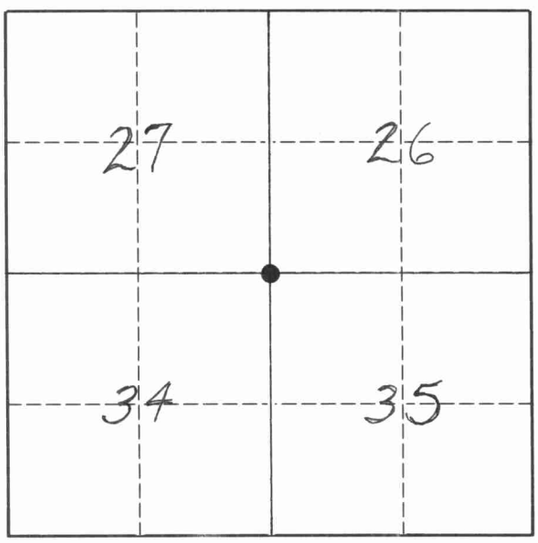

T. 31 N., R. 11 E.

(b) Describe any record evidence, monument evidence, occupational evidence, testimonial evidence or any other material evidence you considered, and whether the monument was found or placed.

The original corner was established in 1860 by Hiram C. Fellows. Original BT's: birch, 8", S33E, 12 lks., and a sugar, 14", N75W, 15 lks. Although B.F. Dorr (in the 1880's) and Malcolm Hutchinson (in the 1910's) apparently both did a moderate amount of survey work in the general vicinity of this corner, I have no records that show a description of the corner or distances measured to it. Corners that both of those surveyors visited in this area were described as stones with "X"'s chiseled in top. On 10/11/95 we dug with backhoe in the center of an E-W town road and in line with old fences N-S. At 2' below the road surface, found a round top field stone with "X" chiseled on top. Accepted this stone as the best evidence the corner. I set a 3"4" x 30" re-bar on east side of stone. I set a 1½" x 18" iron pipe with a 4" brass cap over the stone. Brass cap is 6" below road.

(c) In the plan view drawing below, provide reference ties to at least 4 witness monuments, or, if the location is within a municipality, to at least 2 witness monuments. (Witness monuments shall be made of concrete, natural stone, iron or other equally durable material.)
Describe witness monuments.
⊗ = 3/4" x 30" re-bar with red plastic cap set flush with ground.

FB6-137

(d) Show a plan view drawing depicting the relevant monuments and reference ties which is sufficient in detail to enable accurate relocation of the corner monument if the corner monument is disturbed. Indicate north.

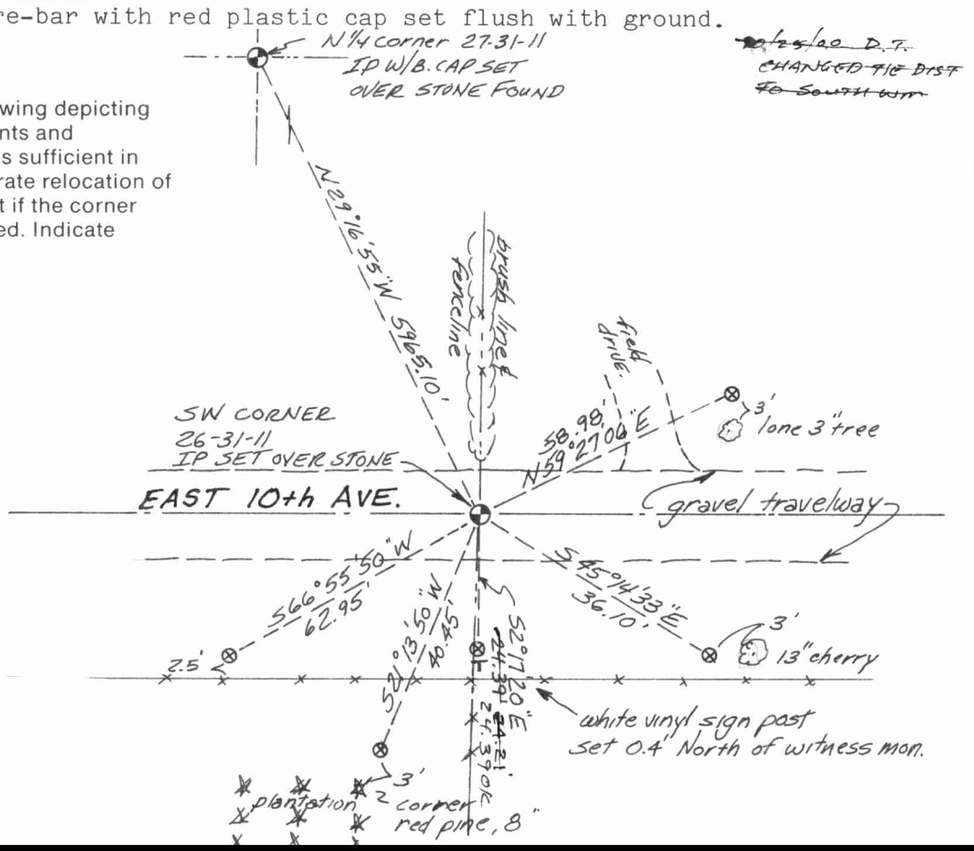

VIT

43111270000

Describe any material discrepancy between the location of the corner as restored or reestablished and the location of that corner as previously restored or reestablished by distance and direction. Show the discrepancy on the plan view drawing under (d), above. Show the distances between the corner as previously restored or reestablished and (1) the corner as restored or reestablished, and (2) to at least 2 of the witness monuments shown on the drawing in (d), above.

No discrepancy.

(f) Was the corner restored through acceptance of (1) an obliterated evidence location, or, (2) a found perpetuated location.?

A found perpetuated location.

(g & h) Was the corner reestablished through lost corner proportionate methods? If so, show the method, including the directions and distances to other public land survey corners used as evidence or used for proportioning in determining the corner location.

No.

Affix Land Surveyor Seal

WISCONSIN
DAVID E.
TLUSTY
S-1390
ANTIGO
WIS.
REGISTERED LAND SURVEYOR

(i) I, David E. Tlusty, Langlade County Surveyor,
(type or print name)
certify that the corner location shown on this record was determined by me or under my direction and control and that this U.S. Public Land Survey Monument Record is correct and complete to the best of my knowledge and belief.

David E Tlusty 10/15/95
Signature Date