LANGLADE COUNTY
U.S. PUBLIC LAND CORNER RESTORATION

The East Quarter corner of Section 5, T. 31 N., R. 12 E., Langlade County, WI.

Corner was: (check all that apply) 43112052000

- [ ] Restored through acceptance of an obliterated evidence location.
- [X] Restored through acceptance of a found perpetuated location.
- [ ] Determined to be lost and re-established through proportionate methods.
  Show bearings and distances to PLSS corners used for proportioning, and show original distances).
- [X] Restored/recovered/re-established in a location that differs from a previously established position.
  (Show difference in plan view below).
- [ ] Check here if addition information is shown on the reverse side of this form.

Describe record evidence, recovered physical evidence, occupational evidence, testimonial evidence and all other evidence considered in the recovery/restoration of the corner.

The original corner was established in 1857 by James McBride. Original bearing trees: sugar, 14", N60°W, 16 links and a birch, 12", S82°E, 14 links. In 1884, Dorr, (FB140-18) surveyed in Section 4 and measured the E-W 1/4 line (79.39 ch) and from this corner to the South (39.74 ch). In approximately 1902, Hutchinson ran the E-W 1/4 line in Sec. 4 and described this corner as "stone 12x12x9 with X on top". He marked a new bearing tree: Elm, 14, N60 1/2°W, 35 lks.
04/25/01 Dan Higginbotham set this corner from at the center of CTH "S" and in line with a fence to the East.
06/21/04 D. Tlusty dug with County backhoe. At 3.0 feet below the road surface, found an upright stone, firmly planted in the original ground. I exposed the top 9" and measured the base as 12" x 12". There is no "X" visible, but the top appears to be chipped/broken a little. There are no other stones to be found. This is obviously the stone mentioned by Hutchinson and I accept it as the best evidence of the original corner location.

Physical description of the monument set:

Did not replace stone found. Set a Berntsen "Deep1" magnet on north edge of stone.

Describe the accessories used to perpetuate the corner. Include a plan view drawing and accessories found/set. Describe measuring point on bearing trees. Show any topographic features that would aid in future recovery of the corner.

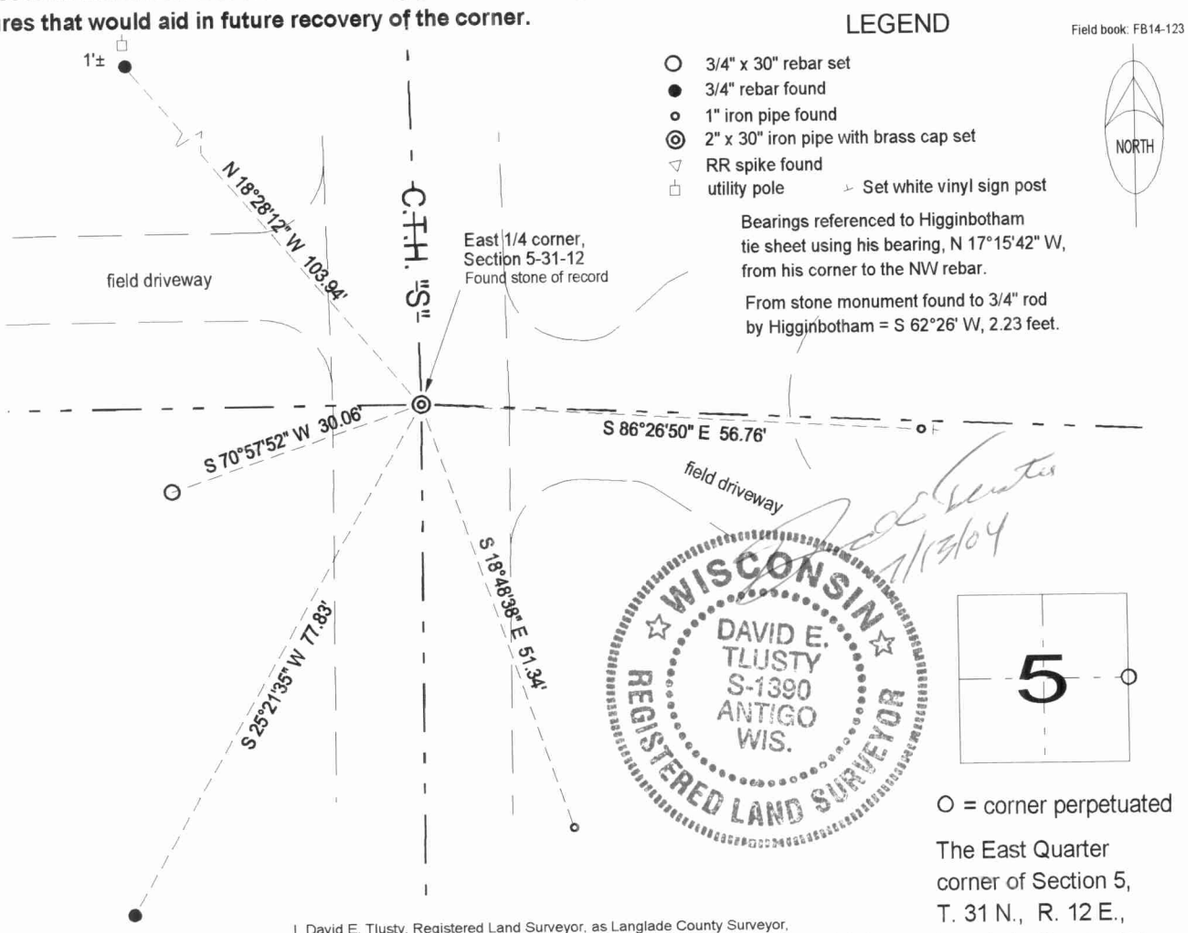

Index No.

5

C9 31-12

O = corner perpetuated

The East Quarter corner of Section 5, T. 31 N., R. 12 E., Langlade County, WI

I, David E. Tlusty, Registered Land Surveyor, as Langlade County Surveyor, **certify that the corner location on this record was determined by me and that** this U.S. Public Land Survey Monument Record is correct to the best of my **knowledge and belief.**