FORM NO. 710

PRESERVATION OF LANDMARKS

PAGE L-9

SECTION 59.635(7) WISCONSIN STATUTES
COUNTY LANGLADE
TOWN EVERGREEN
HIGHWAY STH 64
SECTION NO. 17
T. 31 N., R 13 E.
TYPE OF LANDMARK 1/4 CORNER
LOCATION INDICATED ON SKETCH X

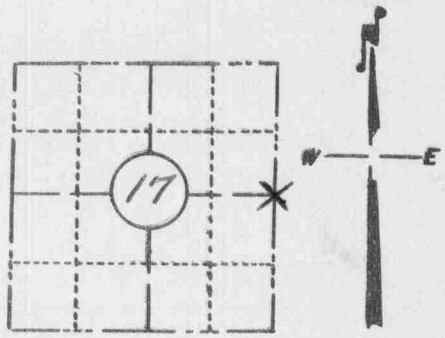

LOCATION SKETCH

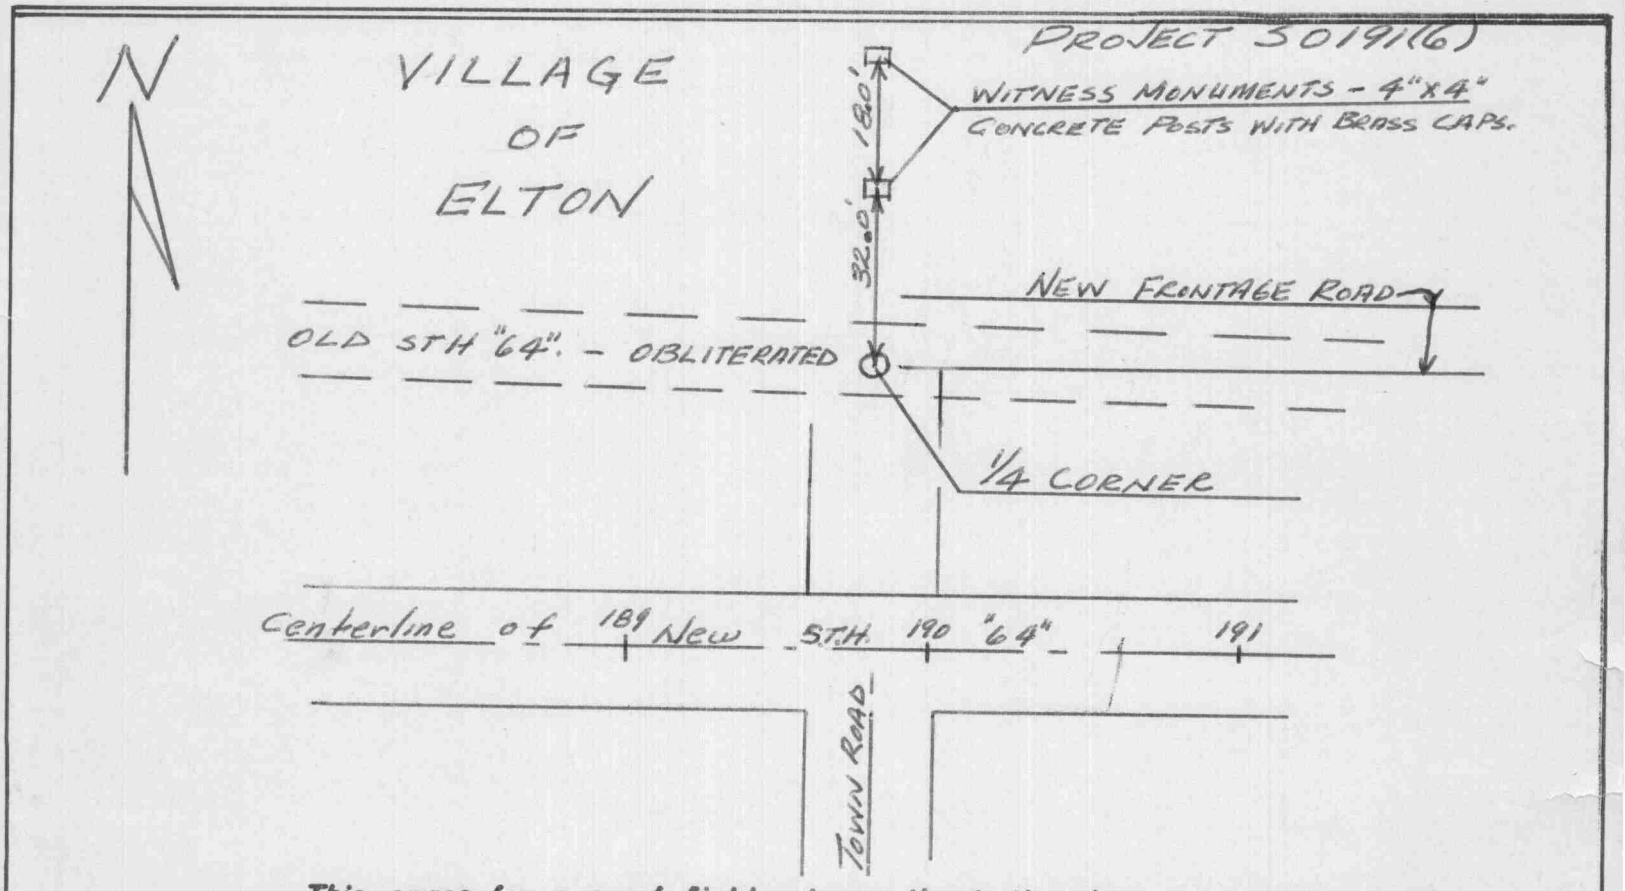

This space for copy of field notes or ties to the above described landmarks

Field notes or records filed in book no. FIELD BOOK NO. 4 - P. 60, 61.
at the STATE HIGHWAY COMMISSION OF WISCONSIN office.
City of RHINELANDER, ONEIDA County.
Located or established by H. M. GOTCHY, 19
Title PROJ. ENGR.

County Clerk's Office Langlade County, Wis. } ss
Received for record Oct 7, 1964
Copy sent to County Surveyor ____, 19____

31-13
L-9

County Clerk