LANGLADE COUNTY
U.S. PUBLIC LAND CORNER RESTORATION

The South Quarter corner of Section 26, T. 32 N., R. 10 E., Langlade County, WI.

Corner was: (check all that apply) 43210260020

- [X] Restored through acceptance of an obliterated evidence location.
- [ ] Restored through acceptance of a found perpetuated location.
- [ ] Determined to be lost and re-established through proportionate methods.
  Show bearings and distances to PLSS corners used for proportioning, and show original distances).
- [ ] Restored/recovered/re-established in a location that differs from a previously established position.
  (Show difference in plan view below).
- [ ] Check here if addition information is shown on the reverse side of this form.

Describe record evidence, recovered physical evidence, occupational evidence, testimonial evidence and all other evidence considered in the recovery/restoration of the corner.

The original corner was established in 1860 by Hiram Fellows. Original bearing trees: tamarac, 10", S45°W, 13 links and a tamarac, 8", N50°W, 5 links. In 1906, E. S. Brooks surveyed the N-S 1/4 line in Section 35. He found the quarter corner set by Webley in road and noted that the original bearing trees were all gone. 10/10/02 D. Tlusty found railroad spike at the center of Bluebell Road and in line with old fences north and south. I accept the location of the railroad spike as the best evidence of the corner, as it falls in the road as mentioned by Brooks and its very probable that the fence through Section 35 was built on the line surveyed by Brooks.

Physical description of the monument set:

I left the existing railroad spike in place.

Describe the accessories used to perpetuate the corner. Include a plan view drawing and accessories found/set. Describe measuring point on bearing trees. Show any topographic features that would aid in future recovery of the corner.

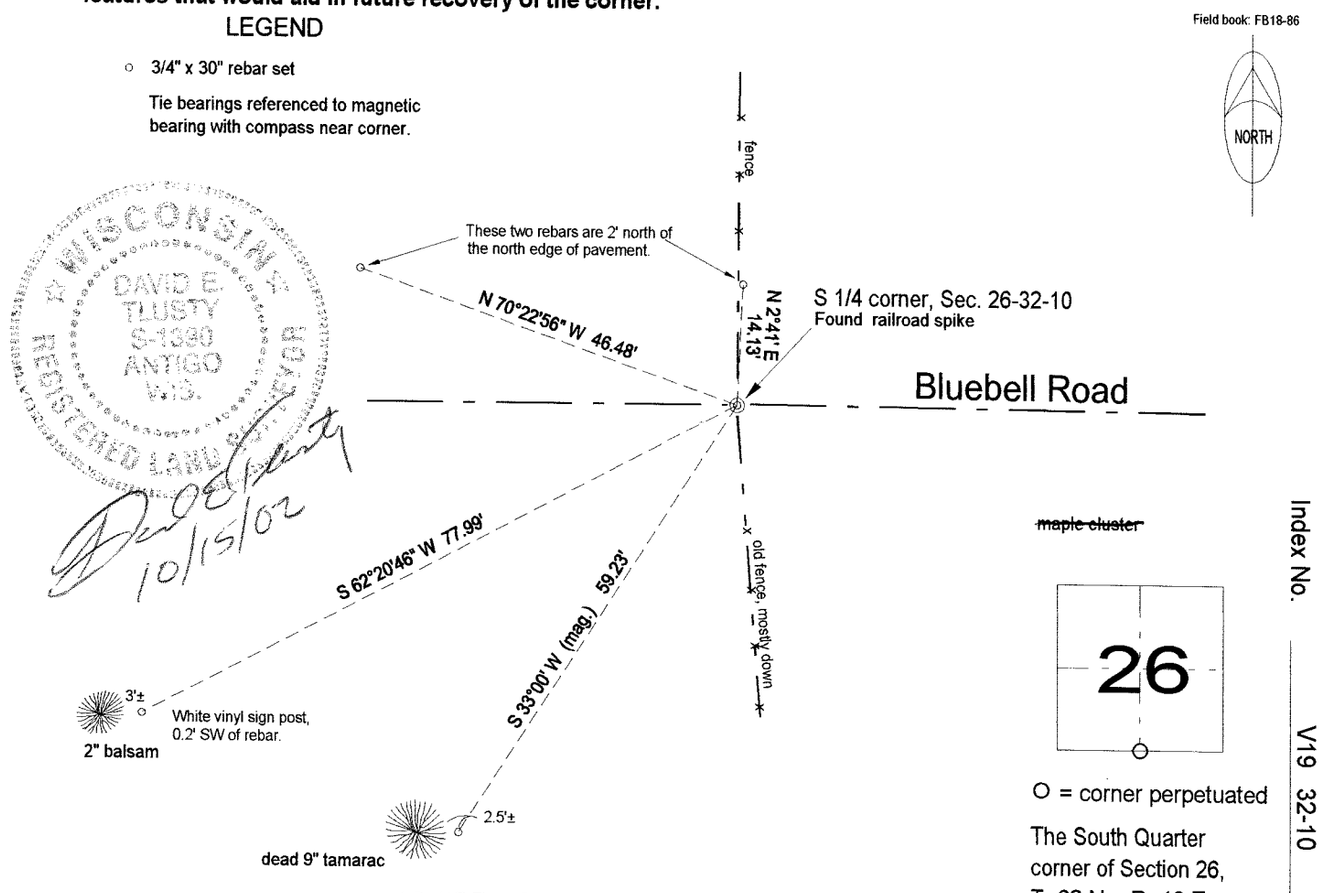

I, David E. Tlusty, Registered Land Surveyor, as Langlade County Surveyor, **certify that the corner location on this record was determined by me and that** this U.S. Public Land Survey Monument Record is correct to the best of my knowledge and belief.